


STATE OF KANSAS
STATE CORPORATION COMMISSION

WELL PLUGGING RECORD

Give All Information Completely
Make Required Affidavit
Mail or Deliver Report to
Conservation Division
State Corporation Comm.
245 North Water
Wichita, KS 67202

Stafford County, Sec. 21 Twp. 24 Rge. 13 E/W
Location as "NE/CNW $\frac{1}{4}$ SW $\frac{1}{4}$ " or footage from lines
C E/2 W/2 NE
Lease Owner W. L. Kirkman, Inc.
Lease Name Owen #1 Well No. _____
Office Address Pratt, Kansas 67124
Character of Well (Completed as Oil, Gas or Dry Hole) _____

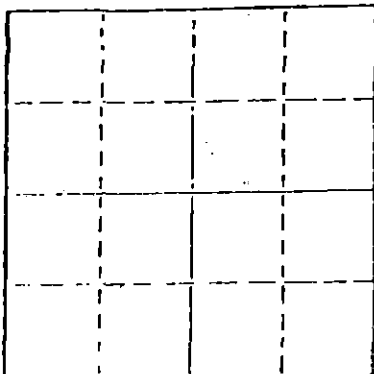

Locate well correctly on above
Section Plot

Date Well completed 19_____
Application for plugging filed 19_____
Application for plugging approved 19_____
Plugging commenced 12/7/79 19_____
Plugging completed 12/11/79 19_____
Reason for abandonment of well or producing formation
depleted.

If a producing well is abandoned, date of last production 19_____
Was permission obtained from the Conservation Division or
its agents before plugging was commenced? yes

Name of Conservation Agent who supervised plugging of this well Owen
Producing formation _____ Depth to top _____ Bottom _____ Total Depth of Well 2005
Show depth and thickness of all water, oil and gas formations.

OIL, GAS OR WATER RECORDS

CASING RECORD

FORMATION	CONTENT	FROM	TO	SIZE	PUT IN	PULLED OUT
				8-5/8	409	none
				4 $\frac{1}{2}$ "	1998	1598'

Describe in detail the manner in which the well was plugged, indicating where the mud fluid was placed and the method or methods used in introducing it into the hold. If cement or other plugs were used, state the character of same and depth placed, from _____ feet to _____ feet for each plug set.

Squeezed 4 $\frac{1}{2}$ " casing with 30 sacks cement, pumped plug to 1700'. Top of cement at 1880'.
Shot pipe at 1585', pulled 48 joints. Squeezed hole with 4 sacks hulls, 25 sacks gel,
4 sacks hulls, released plug and displaced with 125 sacks 50-50 poz, 4% gel and 3% cc.

PLUGGING COMPLETE.

(If additional description is necessary, use BACK of this sheet)

Name of Plugging Contractor KELSO CASING PULLING
CHASE, KANSAS


STATE OF KANSAS COUNTY OF RICE, ss.
R. DARRELL KELSO (employee of owner) or (owner or operator)
of the above-described well, being first duly sworn on oath, says: That I have knowledge of
the facts, statements, and matters herein contained and the log of the above-described well
as filed and that the same are true and correct. So help me God.

(Signature) R. Darrell Kelso
CHASE, KANSAS (Address)

SUBSCRIBED AND SWORN TO before me this 18th day of Dec., 1979

Margaret Melcher
Notary Public.

My commission expires _____

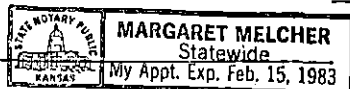

RECEIVED
STATE CORPORATION COMMISSION

DEC 20 1979
12-20-79
CONSERVATION DIVISION
Wichita, Kansas

KANSAS DRILLERS LOG

COMPANY W. L. Kirkman, Inc.

SEC. 21 T. 24S R. 13W
LOC. 330' W of C-NE/4

FARM Owen

NO. 1

COUNTY Stafford

ROTARY TOTAL DEPTH 2,005'
COMM. April 27, 1978
CONTRACTOR H-30, Inc.
ISSUED May 5, 1978

COMP. April 30, 1978

CASING

10 3/4"

8 5/8" Set at 416' cemented w/285 sxs cement

ELEVATION 1,933 K.B.

5 1/2"

4 1/2" Set at 1,998' cemented w/125 sxs cement

FIGURES INDICATE BOTTOM OF FORMATIONS

Sand	296'
Shale and Shells	419'
Red Bed and Shale	773'
Anhydrite	789'
Shale and Shells	1,005'
Shale, Shells and Lime	1,660'
Shale and Lime	1,808'
Shale, Lime and Chert	2,005'
Rotary Total Depth	2,005'

I hereby certify the above and foregoing to be a true and correct log of the above described well as shown by the drilling reports.

H-30, Inc.

Dean Britting
Dean Britting

State of Kansas }
County of Sedgwick } SS:

Suscribed and Sworn to before me a Notary Public in and for said county and state this 5th day

of May, 1978.



Elsie Willison
Elsie Willison - Notary Public

My Commission Expires:
June 30, 1978.

