


STATE OF KANSAS
STATE CORPORATION COMMISSION

WELL PLUGGING RECORD

Give All Information Completely
Make Required Affidavit
Mail or Deliver Report to:
Conservation Division
State Corporation Commission
211 No. Broadway
Wichita, Kansas

Reno County. Sec. 27 Twp. 23S Rge. 4 (W)
Location as "NE/CNW/SW" or footage from lines NW NW SW
Lease Owner Union Texas Natural Gas Corp.
Lease Name Lucy C. Hill Well No. 1
Office Address Drawer D, Great Bend, Kansas
Character of Well (completed as Oil, Gas or Dry Hole) Dry Hole
Date well completed _____ 19____
Application for plugging filed 7-21-61 19
Application for plugging approved 7-21-61 19
Plugging commenced 7-21-61 19
Plugging completed 7-22-61 19
Reason for abandonment of well or producing formation Dry hole

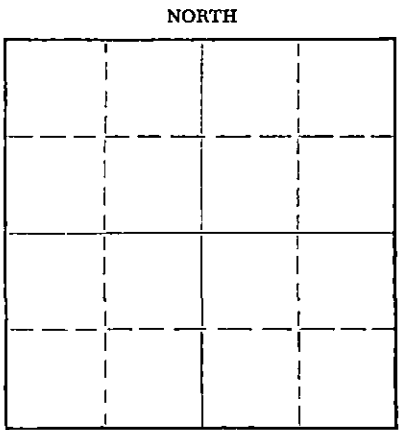

Locate well correctly on above
Section Plat

If a producing well is abandoned, date of last production _____ 19____
Was permission obtained from the Conservation Division or its agents before plugging was commenced? Yes

Name of Conservation Agent who supervised plugging of this well Fred W. Hampel
Producing formation _____ Depth to top _____ Bottom _____ Total Depth of Well 3905 Feet
Show depth and thickness of all water, oil and gas formations.

OIL, GAS OR WATER RECORDS

CASING RECORD

FORMATION	CONTENT	FROM	TO	SIZE	PUT IN	PULLED OUT
				13" OD	164	None
				8 5/8" OD	702'	None

Describe in detail the manner in which the well was plugged, indicating where the mud fluid was placed and the method or methods used in introducing it into the hole. If cement or other plugs were used, state the character of same and depth placed, from _____ feet to _____ feet for each plug set.

TD to 240 Heavy mud.
240 to 160 Howco plug, 1/2 sx hulls, 20 sx cement
160 to 35' heavy mud
35 to surface, Howco plug, 1/2 sx hulls, 10 sx cement
Spotted 2 sx cement in rathole

8-2-61

(If additional description is necessary, use BACK of this sheet)

Name of Plugging Contractor White & Ellis Drilling, Inc.
Address Box 448, El Dorado, Kansas

STATE OF Kansas, COUNTY OF Barton, ss.
Gerald M. Dougherty (employee of owner) or (owner or operator) of the above-described well, being first duly sworn on oath, says: That I have knowledge of the facts, statements, and matters herein contained and the log of the above-described well as filed and that the same are true and correct. So help me God.

(Signature) Gerald M. Dougherty
(Address) _____

SUBSCRIBED AND SWORN TO before me this 31st day of July, 19 61

Vardella M. Hankins
Notary Public.

My commission expires Dec. 4, 1962



15-155-00211-0000

Casing Record

Location: NW 1/4 34

Section: 27-25S-4W

Reno County, Kansas

Farms Hill #1

Well Owner: Union Texas Natural Gas Corp. A-P Div.

Contractor: White & Ellis Drig., Inc.

Started: 7/1/61

Completed: 7/21/61

13"	165' Cemented w/200 sacks
8 5/8	702' Cemented w/470 sacks
T.D.	3905'
Kelly Bushing Measurement 5' above ground level.	
FORMATION	DEPTH
Soil	0-100
Shale & Lime strks.	165
Shale	408
Salt	500
Shale	550
Shale & Lime	850
Lime, hd.	930
Lime & Shale strks.	1015
Lime	1325
Sdy. Shale	1445
Shale & Shells	1710
Lime & Shale strks.	1825
Shale	1880
Lime & Shale	1990
Shale	2025
Lime	2390
Shale & Lime strks.	2525
Shale & Lime shells	2600
Lime	3186
Shale	3209
Lime	3550
Shale	3663
Lime	3740
Shale & Lime	3756
Lime	3780
Sand	3838
Sand & Shale	3863
Lime	3905

TOPS

Kansas City	2600
Mississippi	3299
Munton	3663
Vicia	3766
Simpson	3780
Arbuckle	3873

Dry Hole

Plugged & Abandoned

RECEIVED
STATE CORPORATION COMMISSION

AUG 2 1961

CONSERVATION DIVISION
Wichita, Kansas

8-2-61