

Rec'd
7-18-82

STATE OF KANSAS
STATE CORPORATION COMMISSION
200 Colorado Derby Bldg.
Wichita, Kansas 67202


Form CP-4
Rev. 12-15-80

15-095-21246-0000

WELL PLUGGING RECORD

Give All Information Completely
Make Required Affidavit

COUNTY Kingman SEC. 6 TWP. 27S RGE. 5 EXW
Location as in quarters or footage from lines:
C NW NW SE

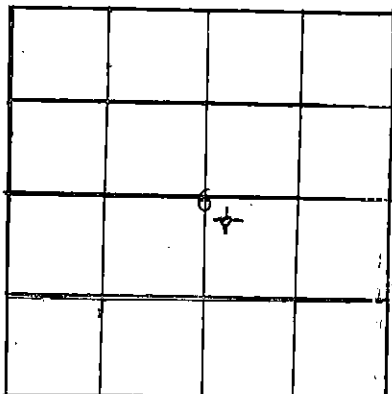

Locate Well
correctly on above
Section Platt.

Lease Owner Luna Energy Corporation
Lease Name Delos V. Smith Well No. 1
Office Address 11201 Dover Court, Yukon, OK 73099
Character of Well (Completed as Oil, Gas or Dry Hole): _____
Date Well Completed July 16, 1982
Application for plugging filed July 15, 1982
Plugging commenced July 16, 1982
Plugging completed July 16, 1982
Reason for abandonment of well or producing formation D&A

Was permission obtained from the Conservation Division or it's
Agent's before plugging was commenced? yes

Name of Conservation Agent who supervised plugging of this well Maurice V. Leslie
Producing formation n/a Depth to top n/a bottom n/a T.D. 2900'
Show depth and thickness of all water, oil and gas formations.

OIL, GAS OR WATER RECORDS

Casing Record

Formation	Content	From	To	Size	Put in	Pulled Out
				8-5/8"	243.82'	-0-

Describe in detail the manner in which the well was plugged, indicating where the mud
fluid was placed and the method or methods used in introducing it into the hold. If cement
or other plugs were used, state the character of same and depth placed, from _____ feet
to _____ feet for each plug set.

Plugged Hole
1st @ 300' w/40 sx
10 sx bulls & plug @ 40' w/10 sx
10 sx in rathole
50-50 poz, 3% C.C.
Dowell

(If additional description is necessary, use BACK of this sheet)

Name of Plugging Contractor Dowell
W. Railroad Ave., Great Bend, KS 67530

STATE OF OKLAHOMA COUNTY OF OKLAHOMA, ss.

Bob G. Luna, President (employee of owner) or (owner or operator) of the
above-described well, being first duly sworn on oath, says: That I have knowledge of the
facts, statements, and matters herein contained and the log of the above-described well as
filed and that the same are true and correct. So help me God.

(Signature) Bob G. Luna
11201 Dover Court, Yukon, Ok.
(Address) 73099

SUBSCRIBED AND SWORN TO before me this 18th day of July, 19 82

Sandra L. Gragg
Notary Public.

My Commission expires: 5/3/83