


15-095-21132-0000

STATE OF KANSAS  
STATE CORPORATION COMMISSION

WELL PLUGGING RECORD

Give All Information Completely  
Take Required Affidavit  
Mail or Deliver Report to  
Conservation Division  
State Corporation Comm.  
245 North Water  
Wichita, KS 67202

Kingman County, Sec. 7 Twp. 27S Rge. 5 E/W  
Location as "NE/CNW $\frac{1}{4}$ /SW $\frac{1}{4}$ " or footage from lines  
NW/4 NW/4 NE/4  
Lease Owner National Oil Company  
Lease Name Young Well No. #13-7  
Office Address 200 W. Douglas, Ste 800, Wichita, KS  
Character of Well (Completed as Oil, Gas or Dry Hole)  
dry hole

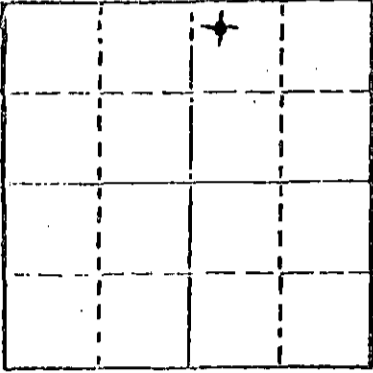

Locate well correctly on above  
Section Plot

Date Well completed 11/3/1981  
Application for plugging filed 11/3/1981  
Application for plugging approved 11/3/1981  
Plugging commenced 11/3/1981  
Plugging completed 11/3/1981  
Reason for abandonment of well or producing formation  
No commercial quantity of oil or gas encountered.  
If a producing well is abandoned, date of last production  
19

Was permission obtained from the Conservation Division or  
its agents before plugging was commenced? yes

Name of Conservation Agent who supervised plugging of this well Mr. Lesli  
Producing formation Depth to top Bottom Total Depth of Well  
Show depth and thickness of all water, oil and gas formations.

OIL, GAS OR WATER RECORDS

CASING RECORD

FORMATION	CONTENT	FROM	TO	SIZE	PUT IN	PULLED OUT

Describe in detail the manner in which the well was plugged, indicating where the mud fluid  
was placed and the method or methods used in introducing it into the hold. If cement or other  
plugs were used, state the character of same and depth placed, from feet to  
feet for each plug set.

Total Depth 3580 feet. Set first plug at 750 feet with 60 sacks of 50/50 poz.  
mix cement, 4% Gel and 3% calcium chloride; second plug at 230 feet with 40  
sacks; 10 sacks and a bridge at 40 feet and 10 sacks in rat hole. Cement by  
Allied Cementing. Job complete at 9:30 P.M. on November 3, 1981.

RECEIVED  
STATE CORPORATION COMMISSION

NOV 23 1981

(If additional description is necessary, use BACK of this sheet) 11-13-81

Name of Plugging Contractor Kaw Drilling Co., Inc. CONSERVATION DIVISION  
Wichita, Kansas

STATE OF KANSAS COUNTY OF SEDGWICK, ss. contractor  
K. S. Martin, President of Kaw Drilling Co., ~~Indeploves of owner~~  
of the above-described well, being first duly sworn on oath, says: That I have knowledge of  
the facts, statements, and matters herein contained and the log of the above-described well  
as filed and that the same are true and correct. So help me God.

(Signature) K. S. Martin  
K. S. Martin, President  
1010 Union Ct (Address) Wichita, KS 67202

SUBSCRIBED AND SWORN TO before me this 12th day of November, 1981.

My commission expires December 10, 1983  
Mary Susan Whaley  
Mary Susan Whaley Notary Public.

