


15-095-00034-0000

STATE OF KANSAS  
STATE CORPORATION COMMISSION

Give All Information Completely  
Make Required Affidavit  
Mail or Deliver Report to:  
Conservation Division  
State Corporation Commission  
211 No. Broadway  
Wichita, Kansas

WELL PLUGGING RECORD

NORTH

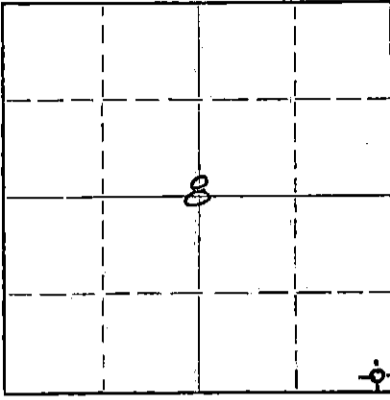

Locate well correctly on above  
Section Plat

Kingman County. Sec. 8 Twp. 27S Rge. 5 (E) W (W)  
Location as "NE/CNW/SW" or footage from lines SE SE SE  
Lease Owner D. R. LAUCK OIL COMPANY, INC.  
Lease Name Tiemeyer Well No. 1  
Office Address 301 S. Broadway Wichita, Kansas  
Character of Well (completed as Oil, Gas or Dry Hole) dry hole  
Date well completed April 7 1961  
Application for plugging filed """ 1961  
Application for plugging approved April 7 1961  
Plugging commenced April 7 1961  
Plugging completed April 7 1961  
Reason for abandonment of well or producing formation Dry Hole

If a producing well is abandoned, date of last production - 19-  
Was permission obtained from the Conservation Division or its agents before plugging was commenced? yes

Name of Conservation Agent who supervised plugging of this well Fred Hampel  
Producing formation \_\_\_\_\_ Depth to top \_\_\_\_\_ Bottom \_\_\_\_\_ Total Depth of Well 4320 Feet  
Show depth and thickness of all water, oil and gas formations.

OIL, GAS OR WATER RECORDS

CASING RECORD

FORMATION	CONTENT	FROM	TO	SIZE	PUT IN	PULLED OUT
		0	217	8 5/8"	217	None

Describe in detail the manner in which the well was plugged, indicating where the mud fluid was placed and the method or methods used in introducing it into the hole. If cement or other plugs were used, state the character of same and depth placed, from \_\_\_\_\_ feet to \_\_\_\_\_ feet for each plug set.

Hole filed with mud 4320 - 210  
plug 210 - 206  
cement 206 - 35  
plug 35 - 31  
cement 31 - 6 Bottom of the collar

RECEIVED  
STATE CORPORATION COMMISSION  
JUN 9 1961  
6-9-61  
CONSERVATION DIVISION  
Wichita, Kansas

(If additional description is necessary, use BACK of this sheet)

Name of Plugging Contractor Haliburton Cementing Company  
Address Pratt, Kansas

STATE OF Kansas, COUNTY OF Sedgwick, ss.  
John H. Knightley (employee of owner) or (owner or operator) of the above-described well, being first duly sworn on oath, says: That I have knowledge of the facts, statements, and matters herein contained and the log of the above-described well as filed and that the same are true and correct. So help me God.

(Signature) John H. Knightley  
(Address) \_\_\_\_\_

SUBSCRIBED AND SWORN to before me this 31st day of May, 19 61

My commission expires Sept. 4, 1962

Helene S. Ramey  
Notary Public.



15-095-00034-0000

D. R. Lauck Oil Company, Inc.

SE SE SE Sec. 8-27S-5W  
Kingman County, Kansas

Tiemeyer # 1

Commenced: March 23, 1961

Completed: April 7, 1961

Casing: Record: 217' 8 5/8" cemented with 175 sacks  
calcium chloride 4 sacks

Elevation: GR 1501; DF 1503; KB 1505

Driller's Log

Tops

Sand	90
Red Bed	217
Shale - Shells	850
Lime & Shale	1725
Shale & Shells	1795
Shale & Lime	2640
Lime & Shale	2862
Shale	2935
Shale & Lime	3055
Lime	3605
Lime & Shale	3700
Shale & Lime	3751
Chert, Lime & Shale	3770
Chert & Lime	3785
Chert & Shale	3840
Chert, Lime & Shale	3880
Chert	3903
Chert, Lime & Shale	3988
Mississippian	4025
Kinderhook	4055
Shale & Lime	4090
Shale, Lime & Sand	4117
Shale & Chert	4150
Shale & Lime	4176
Sand	4200
Sand & Shale	4287
Arbuckle	4320 RTD

Heebner	2740 - 1235
Douglas	2768 - 1263
Lansing	3007 - 1502
Cherokee Shale	3759 - 2254
Mississippian	3759 - 2254
Kinderhook Shale	4034 - 2329
Misneu Sand	4111 - 2606
Viola	4165 - 2660
Simpson Sand	4179 - 2674
Arbuckle	4289 - 2784
Total Depth	4318 - 2813

DST #1 3768-80 Open one hour; good blow throughout. Recovered 120' slightly oil specked watery mud. ISIP 1180# 30 Min. FSIP 956# 30 Min. FP 22-44

DST #2 4183-4192 Open one hour; weak blow two minutes and died. Recovered 60' very slightly oil specked mud. ISIP 1492# 30 Min BSIP 1492# 30 Min. FP 11-33

D & A

RECEIVED  
STATE CORPORATION COMMISSION

JUN 9 1961

CONSERVATION DIVISION  
Wichita, Kansas