


15-095-60321-0000

WELL PLUGGING RECORD

Give All Information Completely
Make Required Affidavit
Mail or Deliver Report to:
Conservation Division
State Corporation Commission
800 Bitting Building
Wichita, Kansas

Kingman County, Sec. 15 Twp. 27 Rge. 5 (E) (W)

NORTH

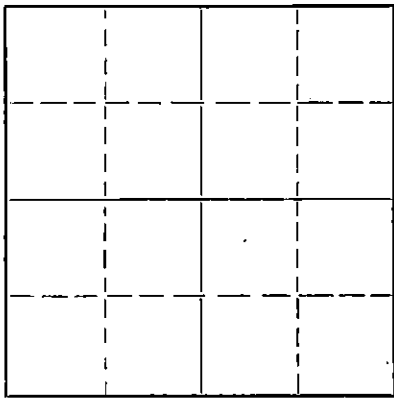

Locate well correctly on above
Section Plat

Location as "NE/CNW/SW" or footage from lines NE NW NW/4
Lease Owner M. B. Armer
Lease Name Ambler Well No. 1
Office Address 710 Petroleum Bldg., Wichita, Kansas
Character of Well (completed as Oil, Gas or Dry Hole) Dry Hole
Date well completed Oct. 9, 1952
Application for plugging filed Oct. 9, 1952
Application for plugging approved Oct. 9, 1952
Plugging commenced Oct. 9, 1952
Plugging completed Oct. 9, 1952
Reason for abandonment of well or producing formation Dry

If a producing well is abandoned, date of last production _____ 19____
Was permission obtained from the Conservation Division or its agents before plugging was commenced? Yes

Name of Conservation Agent who supervised plugging of this well C. D. Stough
Producing formation _____ Depth to top _____ Bottom _____ Total Depth of Well 4366 Feet
Show depth and thickness of all water, oil and gas formations.

OIL, GAS OR WATER RECORDS

CASING RECORD

FORMATION	CONTENT	FROM	TO	SIZE	PUT IN	PULLED OUT
				8-5/8"	219	None

Describe in detail the manner in which the well was plugged, indicating where the mud fluid was placed and the method or methods used in introducing it into the hole. If cement or other plugs were used, state the character of same and depth placed, from _____ feet to _____ feet for each plug set.

Filled hole with heavy drilling mud to 210 ft. set plug
and cemented with twenty sacks cement. Filled hole with
heavy drilling mud to 35 ft., set plug and cemented to
bottom of cellar with ten sacks cement.

10-18-52
Conservation Division
Wichita, Kansas

Name of Plugging Contractor Transit Corporation
Address Oklahoma City, Oklahoma

STATE OF Kansas COUNTY OF Sedgwick, ss.
L. C. Sponenberg (employee of owner) or (owner or operator) of the above-described well, being first duly sworn on oath, says: That I have knowledge of the facts, statements, and matters herein contained and the log of the above-described well as filed and that the same are true and correct. So help me God.

(Signature) L. C. Sponenberg
(Address) _____

SUBSCRIBED AND SWORN TO before me this 17th day of October, 19 52.

My commission expires Sept. 17, 1955.

24-2675-5 2-52-20M



Regal Swanton
Notary Public.
PLUGGING
FILE SEC 15-27-R-52
BOOK PAGE 51 LINE 31

15-095-60321-0000

TRANSIT CORPORATION & M. B. ARMER

AMBLER #1

NE NW NW 15-27-5W
Kingman County, Kansas.

<u>FORMATION</u>	<u>FROM</u>	<u>TO</u>	<u>REMARKS</u>
Surface Clay	0	25	
Sand	25	55	
Shale & Shells	55	820	8 5/8" 10-3/4" CSA @ 219'
Anhydrite	820	845	
Shale & Lime	845	975	Cemented with 200 sacks cement.
Lime	975	1180	
Shale & Lime	1180	1250	
Shale	1250	1290	
Shale & Lime	1290	2085	
Shale & Lime shells	2085	2270	
Shale & Lime	2270	2700	
Bro Lime & Shale	2700	2820	
Shale & Lime	2820	3117	
Lime & Shale	3117	3178	
Lime	3178	3498	
Shale & Lime	3498	3587	
Lime	3487	3625	
Shale & Lime	3625	3716	
Conglomerate	3716	3805	
Lime	3805	3850	
Lime & Chert	3850	3875	
Lime	3875	4100	
Shale & Lime	4100	4160	
Lime & Shale	4160	4207	
Lime	4207	4235	
Sand & Shale	4235	4260	
Sandy lime & Shale	4260	4290	
Lime & Shale	4290	4313	
Sand & Shale	4313	4336	
Lime	4336	4366	
Total Depth		4366	

I hereby certify the foregoing to be a true and correct Driller's Log of the formations encountered in the above well.

TRANSIT CORPORATION

By L. J. Kruse
L. J. Kruse, Assutant Secretary.

Subscribed and sworn to before me this 16th day of October, 1952.

Betty Ben Garvin
Betty Ben Garvin, Notary Public.

My commission expires September 25, 1956.

RECEIVED
OCT 16 1952
REGISTRATION DIVISION
KANSAS

PLUGGING
FILE SEC 15-27-5W
BOOK PAGE 5 / LINE 31