


Give All Information Completely
Make Required Affidavit
Mail or Deliver Report to:
Conservation Division
State Corporation Commission
211 No. Broadway
Wichita, Kansas

NORTH

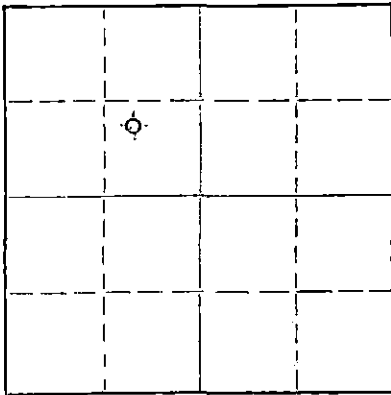

Locate well correctly on above
Section Plat

Russell County. Sec. 33 Twp. 15 Rge. 15 (E) W (W)
Location as "NE/CNW/SW" or footage from lines NW SE NW
Lease Owner C-G Drilling Co.
Lease Name Wegele Well No. 1
Office Address 107 Rule Building, Wichita 2, Kansas
Character of Well (completed as Oil, Gas or Dry Hole) Dry Hole
Date well completed July 9, 1963
Application for plugging filed July 9, 1963
Application for plugging approved July 9, 1963
Plugging commenced July 9, 1963
Plugging completed July 9, 1963
Reason for abandonment of well or producing formation Too low structurally

If a producing well is abandoned, date of last production 19
Was permission obtained from the Conservation Division or its agents before plugging was commenced? Yes

Name of Conservation Agent who supervised plugging of this well Donald Truan, Russell, Kansas
Producing formation Depth to top Bottom Total Depth of Well 3380 Feet
Show depth and thickness of all water, oil and gas formations.

OIL, GAS OR WATER RECORDS

CASING RECORD

FORMATION	CONTENT	FROM	TO	SIZE	PUT IN	PULLED OUT
				8-5/8"	295.93	None

Describe in detail the manner in which the well was plugged, indicating where the mud fluid was placed and the method or methods used in introducing it into the hole. If cement or other plugs were used, state the character of same and depth placed, from feet to feet for each plug set.

Filled hole with heavy mud to 290'. Set plug. Put in 20 sacks cement. Filled with heavy mud to 35'. Set plug. Filled to top with 1/2 sack bulls and 10 sacks cement.

RECEIVED
STATE CORPORATION COMMISSION

JUL 17 1963

CONSERVATION DIVISION
Wichita, Kansas

(If additional description is necessary, use BACK of this sheet)

Name of Plugging Contractor C-G Drilling Co.
Address 107 Rule Building, Wichita 2, Kansas

STATE OF KANSAS, COUNTY OF SEDGWICK, ss.
G. F. Galloway (employee of owner) or (owner or operator) of the above-described well, being first duly sworn on oath, says: That I have knowledge of the facts, statements, and matters herein contained and the log of the above-described well as filed and that the same are true and correct. So help me God.

(Signature) G. F. Galloway 107 Rule Building
(Address)

SUBSCRIBED AND SWORN TO before me this 11th day of July, 1963

My commission expires May 20, 1967

Vicky Jacobs

Notary Public.

WELL LOG

OPERATOR	C-G Drilling Co.	SEC.	33-15-15W
WELL NAME	Wegele #1	LOC.	NW SE NW
TOTAL DEPTH	3380'	COUNTY	Russell
COMM.	July 1, 1963	COMP.	July 9, 1963
RIG NO.	2	STATE	Kansas
CASING:	Set 295.93' (10 jts.) 8-5/8" OD Surface Casing	ELEVATION	1904 K.B.
		PRODUCTION:	Dry & Abandoned

All measurements taken from the top of rotary bushing.

FROM	TO	FORMATION	DEVIATION FROM VERTICAL	REMARKS:
0	480	Shale		
480	585	Sand	500' - 00	
585	815	Red Bed		
815	960	Shale		
960	990	Anhydrite		
990	1325	Shale & shell	1000' - 00	
1325	1485	Shale		
1485	1715	Shale & Lime	1500' - 00	
1715	3045	Lime & Shale	2000' - 00	
3045	3380	Lime	2500' - 00	
			3000' - 00	

RECEIVED
STATE CORPORATION COMMISSION

JUL 17 1963

CONSERVATION DIVISION
Wichita, Kansas

STATE OF KANSAS)
COUNTY OF SEDGWICK) SS.

The undersigned hereby certifies that to the best of his knowledge and belief, the above facts are true and correct.

C-G DRILLING CO.

By G. F. Galloway

SUBSCRIBED AND SWORN TO, BEFORE ME, THIS 10 day of July, 1963.

My commission expires:
May 26, 1967

Vicky Jacobs
Vicky Jacobs - Notary Public