

STATE OF KANSAS
STATE CORPORATION COMMISSION

WELL PLUGGING RECORD

Give All Information Completely
Make Required Affidavit
Mail or Deliver Report to
Conservation Division
State Corporation Comm.
245 North Water
Wichita, KS 67202

Stafford County. Sec. 20 Twp. 24S Rge. 13W E/W
Location as "NE/CNW/SW" or footage from lines _____

C-NE NW SW
Lease Owner W. L. Kirkman, Inc.
Lease Name Mason Well No. 1


Office Address 453 S. Webb Rd., P.O. Box 18611, Wichita,
Character of Well (Completed as Oil, Gas or Dry Hole) KS
Dry Hole 67207

Date Well completed April 26, 1979
Application for plugging filed Verbal Application 19
Application for plugging approved April 26, 1979
Plugging commenced April 26, 1979
Plugging completed 19
Reason for abandonment of well or producing formation _____

If a producing well is abandoned, date of last production 19

Was permission obtained from the Conservation Division or its agents before plugging was commenced? Yes

Name of Conservation Agent who supervised plugging of this well Wm. T. Owen
Producing formation _____ Depth to top _____ Bottom _____ Total Depth of Well 1,946'
Show depth and thickness of all water, oil and gas formations.

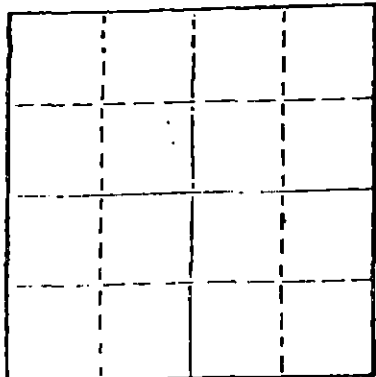

Locate well correctly on above Section Plat

OIL, GAS OR WATER RECORDS

CASING RECORD

FORMATION	CONTENT	FROM	TO	SIZE	PUT IN	PULLED OUT
				8-5/8"	444'	None

Describe in detail the manner in which the well was plugged, indicating where the mud fluid was placed and the method or methods used in introducing it into the hold. If cement or other plugs were used, state the character of same and depth placed, from _____ feet to _____ feet for each plug set.

Filled hole with heavy rotary mud from 1,946 ft. (rotary total depth) to 440 ft. Set plug at 440 ft. and cemented with 40 sacks cement. Filled hole with heavy rotary mud from 440 ft. to 40 ft. Set solid plug at 40 ft. and cemented to cellar with 10 sacks cement, 3 sacks cement in rat/hole.

Plugging operations accomplished utilizing Sun Oil Well cementing pump truck through 4 1/2 inch drill pipe.

RECEIVED
STATE CORPORATION COMMISSION
5-9-79
MAY 9 1979

(If additional description is necessary, use BACK of this sheet)

Name of Plugging Contractor Sun Oilwell Cementing, Inc.
Box 169, Great Bend, Kansas 67530 CONSERVATION DIVISION
Wichita, Kansas

STATE OF Kansas COUNTY OF Sedgwick, ss.
Dean Britting, Agent ~~XXXXXXXXXXXXXXXXXXXX~~ of owner ~~XXXXXXXXXXXXXXXXXXXX~~


of the above-described well, being first duly sworn on oath, says: That I have knowledge of the facts, statements, and matters herein contained and the log of the above-described well as filed and that the same are true and correct. So help me God.

(Signature) Dean Britting
200 N. Main, Wichita, Kansas 67202
(Address)

SUBSCRIBED AND SWORN TO before me this 8th day of May, 1979

Elsie Willison
Elsie Willison - Notary Public.

My commission expires July 25, 1982

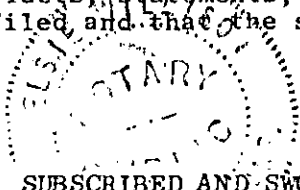

KANSAS DRILLERS LOG

COMPANY W. L. Kirkman, Inc.

SEC. 20 T. 24S R. 13W
LOC. C-NE NW SW

FARM Mason

NO. 1

COUNTY Stafford

ROTARY TOTAL DEPTH 1,946'

COMM. April 24, 1979

COMP. April 26, 1979

CONTRACTOR H-30, Inc. (Rig #7)

ISSUED May 8, 1979

CASING

10 3/4"

8 5/8" Set at 444' cemented w/325 sxs cement

5 1/2"

4 1/2"

ELEVATION 1,938' K.E.

FIGURES INDICATE BOTTOM OF FORMATIONS

Sand and Shale	450'
Shale	1,684'
Shale and Lime	1,802'
Lime and Shale	1,946'
Rotary Total Depth	1,946'

I hereby certify the above and foregoing to be a true and correct log of the above described well as shown by the drilling reports.

H-30, Inc.

Dean Britting
Dean Britting

State of Kansas }
County of Sedgwick } ss:

Subscribed and Sworn to before me a Notary Public in and for said county and state this 8th day of May, 1979.



Elsie Willison
Elsie Willison - Notary Public

My Commission Expires:
July 25, 1982

RECEIVED
STATE CORPORATION COMMISSION

MAY - 9 1979
5-9-79
CONSERVATION DIVISION
Wichita, Kansas