


15-185-11986-0000

STATE OF KANSAS  
STATE CORPORATION COMMISSION

WELL PLUGGING RECORD

Give All Information Completely  
Make Required Affidavit  
Mail or Deliver Report to:  
Conservation Division  
State Corporation Commission  
800 Blitt Building  
Wichita, Kansas

Stafford County. Sec. Twp. Rge. (E) (W)  
Location as "NE/CNW $\frac{1}{4}$ SW $\frac{1}{4}$ " or footage from lines C. NE/4  
Lease Owner D. E. Dunne, Jr.  
Lease Name Russell Well No. 1  
Office Address 1005 Central Building, Wichita, Kansas  
Character of Well (completed as Oil, Gas or Dry Hole) Dry Hole  
Date well completed 12-16 19 57  
Application for plugging filed 1-16 19 58  
Application for plugging approved 1-14 19 58  
Plugging commenced 1-8 19 58  
Plugging completed 1-8 19 58  
Reason for abandonment of well or producing formation Dry Hole

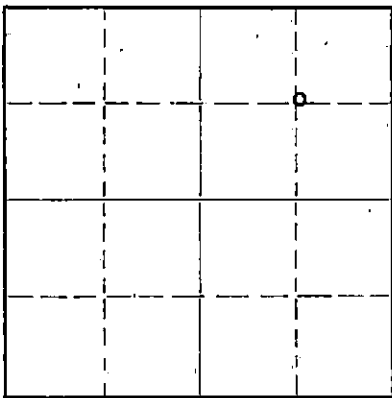

Locate well correctly on above  
Section Plat

If a producing well is abandoned, date of last production 19  
Was permission obtained from the Conservation Division or its agents before plugging was commenced? Yes

Name of Conservation Agent who supervised plugging of this well Frank Broadfoot, 222 S. Main, St. John, Kansas  
Producing formation Depth to top Bottom Total Depth of Well 4115 Feet  
Show depth and thickness of all water, oil and gas formations.

OIL, GAS OR WATER RECORDS

CASING RECORD

Formation	Content	From	To	Size	Put In	Pulled Out
				8 5/8	243'	-

Describe in detail the manner in which the well was plugged, indicating where the mud fluid was placed and the method or methods used in introducing it into the hole. If cement or other plugs were used, state the character of same and depth placed, from feet to feet for each plug set.

Set bottom plug at 215'. Cemented through drill pipe  
with 20 sacks mixed cement. Set top plug at 30'  
and capped with 10 sacks of mixed cement.

RECEIVED  
STATE CORPORATION COMMISSION

JAN 17 1958

CONSERVATION DIVISION  
Wichita, Kansas

1-17-58

(If additional description is necessary, use BACK of this sheet)

Correspondence regarding this well should be addressed to D. E. Dunne, Jr.  
Address 1005 Central Building, Wichita, Kansas

STATE OF Kansas, COUNTY OF Sedgwick, ss.  
D. E. Dunne, Jr. (employee of owner) or (owner or operator) of the above-described well,  
being first duly sworn on oath, says: That I have knowledge of the facts, statements, and matters herein contained and the log of the above-described well as filed and that the same are true and correct. So help me God.

(Signature) [Handwritten Signature]  
(Address)

SUBSCRIBED AND SWORN to before me this 16 day of January 19 58

[Handwritten Signature] Notary Public.

My commission expires September 9, 1961

PLUGGING  
FILE SEC 201 24 R 130  
BOOK PAGE 75 LINE 37

WELL LOG

Well: Russell #1

Location: C NE/4  
Section 20-24S-13W  
Stafford County, Kansas

Operator: D. E. Dunne, Jr.  
1005 Central Building  
Wichita, Kansas

Contractor: Twin Drilling, Inc.  
1005 Central Building  
Wichita, Kansas

Commenced: 12-16-57  
Completed: 1- 8-58

Casing Record:  
8 5/8" 243' W/150 Sacks Cement

Sand	100	Chert Lime	4065
Shale	495	Shale & Sand	4080
Sand & Shale	787	Lime	4115 R.T.D.
Anhydrite	806		
Shale	1090	Dry Hole	
Shale & Shells	1450		
Lime & Shale	1740		
Lime	1840		
Lime W/Shale Breaks	2010		
Lime	2345		
Shale & Lime	2590		
Lime	2705		
Shale & Lime	3000		
Lime W/Shale Breaks	3205		
Lime	3230		
Shale & Lime	3299		
Lime	3414		
(Heebner 3406)			
Shale W/Lime Streaks	3585		
(Br. Lime 3545)			
(Lansing 3568)			
Lime	3652		
Lime W/Shale Breaks	3731		
Lime	3808		
Lime W/Shale Breaks	3875		
(Kansas City 3832)			
Lime & Chert	3919		
(Conglomerate 3884)			
(Viola 3907)			
Lime	4025		

1-17-58

STATE COMMISSION

JAN 17 1958

PROSPECTIVE DIVISION

STATE OF KANSAS )  
                          ) ss.  
COUNTY OF SEDGWICK )

The undersigned, TWIN DRILLING, INC., hereby certifies that the above log is a true and correct log of the formations encountered in drilling the above well as reflected by the Daily Drilling Report.

TWIN DRILLING, INC.  
By Almeda Neay  
Secretary

Subscribed and sworn to before me this 16th day of January, 1958.

James S. Hicks  
Notary Public

My commission expires  
September 29, 1960.

PLUGGING			
FILE	SEC	T	R
BOOK	PAGE	LINE	