

15-185-21611-0000


STATE OF KANSAS
STATE CORPORATION COMMISSION
200 Colorado Derby Bldg.
Wichita, Kansas 67202

Form CP-4
Rev. 12-15-80

WELL PLUGGING RECORD

Give All Information Completely
Make Required Affidavit

COUNTY Stafford SEC. 19 TWP. 24S RGE. 13WE/W
Location as in quarters or footage from lines:
SE NW SE

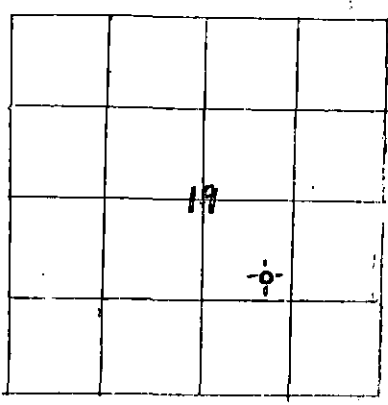

Locate Well
correctly on above
Section Platt.

Lease Owner Catt Drilling Co., Inc.
Lease Name Dudrey Well No. 4
Office Address P.O. Box 220, Holyrood, KS 67450
Character of Well (Completed as Oil, Gas or Dry Hole): Dry hole
Date Well Completed May 17, 1982
Application for plugging filed May 17, 1982
Plugging commenced May 17, 1982
Plugging completed May 17, 1982
Reason for abandonment of well or producing formation _____

Was permission obtained from the Conservation Division or it's
Agent's before plugging was commenced? yes

Name of Conservation Agent who supervised plugging of this well Bud Metz
Producing formation _____ Depth to top _____ bottom _____ T.D. 4168
Show depth and thickness of all water, oil and gas formations.

OIL, GAS OR WATER RECORDS

Casing Record

Formation	Content	From	To	Size	Put in	Pulled Out
Surface	shale	0	219	8-5/8	216	none
	cemented with 200 plug down at 8:30 circulate.	200	5-10-82	60/40 posmix, 2% gel, 3% cc, by Allied;		cement did

Describe in detail the manner in which the well was plugged, indicating where the mud
fluid was placed and the method or methods used in introducing it into the hold. If cement
or other plugs were used, state the character of same and depth placed, from _____ feet
to _____ feet for each plug set.


Plugged as follows w/120 sx 50/50 posmix;
60 sx @ 600'
40 sx @ 240'
10 sx & solid bridge @ 40'
10 sx in rat hole; completed at 12:30 a.m. 5-18-82 by Allied.

(If additional description is necessary, use BACK of this sheet)
Name of Plugging Contractor Husky Drilling Co., Inc.

STATE OF KANSAS COUNTY OF SEDGWICK, ss.
Jon T. Williams, Jr. (employee of owner) or (owner or operator) of the
above-described well, being first duly sworn on oath, says: That I have knowledge of the
facts, statements, and matters herein contained and the log of the above-described well as
filed and that the same are true and correct. So help me God.

(Signature) [Handwritten Signature]
200 E. First, Suite 500, Wichita, Kansas
(Address)

SUBSCRIBED AND SWORN TO before me this 17th day of May, 1982

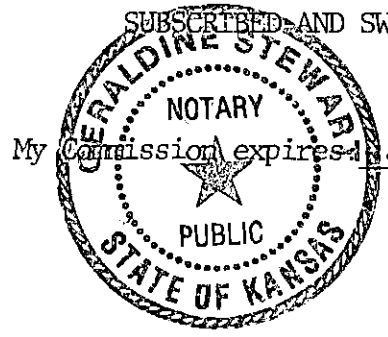

Geraldine Stewart
Geraldine Stewart Notary Public.

RECEIVED
STATE CORPORATION COMMISSION

5-21-82 MAY 21 1982

CONSERVATION DIVISION
Wichita, Kansas