


15-185-01201-0000

STATE OF KANSAS
STATE CORPORATION COMMISSION

Give All Information Completely
Make Required Affidavit
Mail or Deliver Report to:
Conservation Division
State Corporation Commission
211 No. Broadway
Wichita, Kansas

WELL PLUGGING RECORD

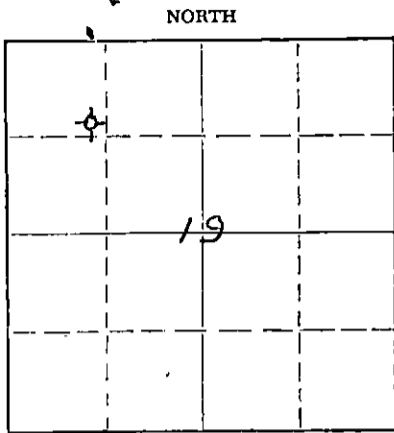

Locate well correctly on above
Section Plat

Stafford County. Sec. 19 Twp. 24S Rge. 13W (E) (W)
Location as "NE/CNW/SW" or footage from lines. SE NW NW
Lease Owner D. R. Lauck Oil Company, Inc.
Lease Name Toland Well No. 21
Office Address 301 South Broadway
Character of Well (completed as Oil, Gas or Dry Hole) Dry Hole
Date well completed June 11 19 61
Application for plugging filed June 11 19 61
Application for plugging approved June 11 19 61
Plugging commenced June 11 19 61
Plugging completed June 11 19 61
Reason for abandonment of well or producing formation Dry Hole

If a producing well is abandoned, date of last production _____ 19____
Was permission obtained from the Conservation Division or its agents before plugging was commenced? Yes

Name of Conservation Agent who supervised plugging of this well Frank Broadfeet
Producing formation _____ Depth to top _____ Bottom _____ Total Depth of Well 4100 Feet
Show depth and thickness of all water, oil and gas formations.

OIL, GAS OR WATER RECORDS

CASING RECORD

FORMATION	CONTENT	FROM	TO	SIZE	PUT IN	PULLED OUT
		0	223	8 5/8"	223	None

Describe in detail the manner in which the well was plugged, indicating where the mud fluid was placed and the method or methods used in introducing it into the hole. If cement or other plugs were used, state the character of same and depth placed, from _____ feet to _____ feet for each plug set.

Hole Filled with mud	4100' to	200'
Set Plug	200' to	196'
20 sacks cement	196' to	156'
Mud	156' to	35'
Plug	35' to	31'
Cement	31' to	6' Bottom of cellar

RECEIVED
STATE CORPORATION COMMISSION
JUN 28 1961
CONSERVATION DIVISION
Wichita, Kansas

(If additional description is necessary, use BACK of this sheet)

Name of Plugging Contractor Haliburton Cement Company
Address Pratt, Kansas

STATE OF Kansas, COUNTY OF Sedgwick, ss.
John H. Knightley (employee of owner) or (owner or operator) of the above-described well, being first duly sworn on oath, says: That I have knowledge of the facts, statements, and matters herein contained and the log of the above-described well as filed and that the same are true and correct. So help me God.

(Signature) John H. Knightley
301 South Broadway
(Address)

SUBSCRIBED AND SWORN TO before me this 26th day of June, 19 61

Helene S. Ramey
Helene S. Ramey Notary Public.

My commission expires September 4, 1962

D. R. LAUCK OIL COMPANY, INC.
TOLAND # 1

15-185-01201-0000

SE NW NW Sec. 19-24S-13W
Stafford County, Kansas

Commenced: June 1, 1961
Completed: June 11, 1961
Casing Record: 223'

8 5/8" Cemented with 180 sacks
Calcium Chloride 4 sacks

Elevation: GR 1932; DF 1935; KB 1937

Drillers Log

Tops

%

Surface Clay	15
Sand	128
Shale	223
Red Bed	305
Sand	330
Red Bed	825
Anhydrite	855
Red Bed & Shells	1045
Red Bed & Shale	1200
Shale & Shells	1695
Lime & Shale	1905
Lime	2035
Lime & Shale	2180
Shale & Lime	2400
Shale & Shells	2555
Shale & Lime	3050
Lime & Shale	3140
Shale & Lime	3270
Lime & Shale	3395
Lime	3461
Heebner	3466
Lime	3470
Shale & Lime	3630
Lime	3978
Lime & Shale	3987
Mississippi	3998
Chert, Lime, & Shale	4018
Shale & Chert	4100

	Sample	Walex
Heebner	3461-1524	3454-1522
Toronto	3482-1545	3480-1543
Brown Lime	3599-1662	3598-1661
Lansing-Kansas City	3631-1694	3630-1693
Base Kansas City		3872-1935
Mississippian	3987-2050	3986-2049
Kinderhook	4016-2078	4018-2077
Viola	4077-2140	4076-2139
Total Depth	4100-2163	4100-2163

DST #1 (s) 3988-3998 Open 30 Minutes.
Weak blow 10 min. and died. Recovered
10 feet of Drilling mud.
ISIP 200# 15Min.
FSIP Zero 30 Min.
FP 0 0

DST #2 (s) 3998-4018 Open 1 hour. Weak
Blow thru - out. Recovered 130' watery
Mud.
ISIP 1440# 30 Min.
FSIP 1360# 30 Min.

RTD

D & A

RECEIVED
STATE CORPORATION COMMISSION

JUN 28 1961

CONSERVATION DIVISION
Wichita, Kansas