

15-185-00530-0000

STATE OF KANSAS
STATE CORPORATION COMMISSION

Give All Information Completely
Make Required Affidavit
Mail or Deliver Report to:
Conservation Division
State Corporation Commission
800 Bittling Building
Wichita, Kansas

WELL PLUGGING RECORD

Stafford County. Sec. 19 Twp. 24 Rge. 13 (E) W (W)

Location as "NE/CNW/SW" or footage from lines NW NW NW

Lease Owner Hilton Drilling Company, Inc.

Lease Name Toland Well No. 1

Office Address 2421 Tenth Street, Great Bend, Kansas

Character of Well (completed as Oil, Gas or Dry Hole) dry hole

Date well completed March 31 1954

Application for plugging filed March 30 1954

Application for plugging approved March 30 1954


Plugging commenced March 30 1954

Plugging completed March 31 1954

Reason for abandonment of well or producing formation dry hole

If a producing well is abandoned, date of last production 19

Was permission obtained from the Conservation Division or its agents before plugging was commenced? yes

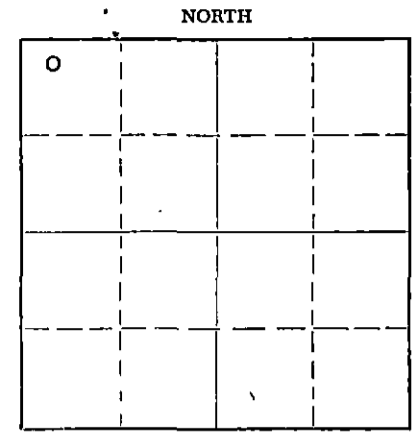

Locate well correctly on above Section Plat

Name of Conservation Agent who supervised plugging of this well M. A. Rives

Producing formation Depth to top Bottom Total Depth of Well 3947 Feet

Show depth and thickness of all water, oil and gas formations.

OIL, GAS OR WATER RECORDS

CASING RECORD

FORMATION	CONTENT	FROM	TO	SIZE	PUT IN	PULLED OUT
		0	201	8 5/8	201	none

Describe in detail the manner in which the well was plugged, indicating where the mud fluid was placed and the method or methods used in introducing it into the hole. If cement or other plugs were used, state the character of same and depth placed, from feet to feet for each plug set.

Hole filled with heavy rotary mud from total depth to 200 ft. Bottom plug set at 200 ft. with 20 sacks cement. Top plug set at 40 ft. hole filled to surface with 10 sacks cement.

4-12-54

(If additional description is necessary, use BACK of this sheet)

Name of Plugging Contractor Hilton Drilling Company, Inc.
Address P. O. Box 108, Great Bend, Kansas

STATE OF KANSAS, COUNTY OF ~~ST~~ BARTON, ss.
Henry Peacock, Secretary (employee of owner) or (owner or operator) of the above-described well, being first duly sworn on oath, says: That I have knowledge of the facts, statements, and matters herein contained and the log of the above-described well as filed and that the same are true and correct. So help me God.

(Signature) *Henry Peacock*
2421 Tenth Street, Great Bend, Kansas
(Address)

SUBSCRIBED AND SWORN TO before me this 1st day of April, 1954

Margaret Whitmore
Notary Public.

My commission expires April 4, 1956

24-2675-S 2-52-20M
PLUGGED
APR 19 24 21 36
24 19

DRILLER'S LOG


Company:	Hilton Drilling Company, Inc.	LOCATION:	NW NW NW Sec. 19-24S-13W Stafford County Kansas
Contractor:	Hilton Drilling Company, Inc.		
Farm Name:	Toland No. 1	ELEVATION:	1938 KB
Commenced:	3-18-1954	CASING USED:	8-5/8" @ 201' w/200 sacks
Completed:	3-31-1954		

Surface Soil and Sand	40
Sand	130
Shale	201
Red Bed	280
Sand	315
Red Bed and Shale	805
Anhydrite	830
Red Bed and Shale	1055
Shale and Shells	1250
Shale and Salt	1400
Shale and Shells	1715
Bro. Lime	1875
Bro. Lime and Shale	1980
Lime	2065
Lime, Sand and Shale	2240
Lime and Shale	2595
Bro. Lime and Shale	2750
Shale and Lime	3010
Lime	3318
Lime and Shale	3357
Lime	3475
Lime and Shale	3586
Brown Lime	3610
Lime	3855
Lime and Shale	3890
Lime, Shale and Conglomerate	3943
Lime	3947
TOTAL DEPTH	3947

STATE OF KANSAS)
) ss.
 COUNTY OF BARTON)

4-9-54

I, the undersigned, being duly sworn on oath state that the above statement and log are true and a correct record and log of the well drilled at the location above described.

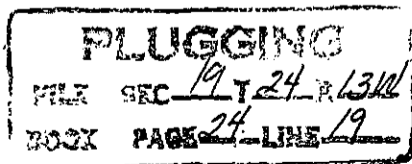

HILTON DRILLING COMPANY, INC.

Henry Peacock
 Henry Peacock, Secretary

Subscribed and sworn to before me this 1st day of April, 1954.

Margaret Whitman
 Notary Public

My commission expires 4-4-56