

STATE OF KANSAS  
STATE CORPORATION COMMISSION


Give All Information Completely  
Make Required Affidavit  
Mail or Deliver Report to:  
Conservation Division  
State Corporation Commission  
211 No. Broadway  
Wichita, Kansas

WELL PLUGGING RECORD

Stafford County, Sec. 17 Twp. 24 Rge. (E) 13 (W)

Location as "NE/CNW/SW" or footage from lines SE SW NW  
Lease Owner D. R. Lauck Oil Co., Inc.  
Lease Name Roenbaugh Well No. 1  
Office Address 301 South Broadway, Wichita, Kansas  
Character of Well (completed as Oil, Gas or Dry Hole) Dry Hole  
Date well completed September 14 19 62  
Application for plugging filed September 14 19 62  
Application for plugging approved September 17 19 62  
Plugging commenced September 18 19 62  
Plugging completed September 26 19 62  
Reason for abandonment of well or producing formation Non Productive

NORTH

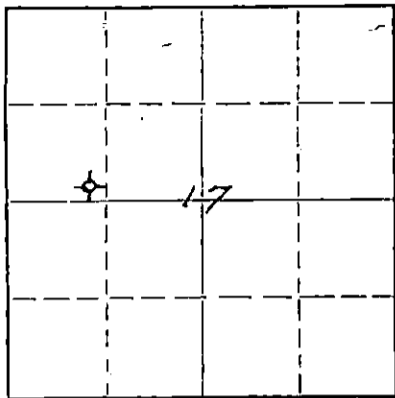

Locate well correctly on above  
Section Plat

If a producing well is abandoned, date of last production 19  
Was permission obtained from the Conservation Division or its agents before plugging was commenced? Yes

Name of Conservation Agent who supervised plugging of this well Mr. W. L. Lackamp  
Producing formation Mississippi Depth to top 3929 Bottom 4004 Total Depth of Well 4225 Feet  
Show depth and thickness of all water, oil and gas formations. P.B. 4124

OIL, GAS OR WATER RECORDS

CASING RECORD

FORMATION	CONTENT	FROM	TO	SIZE	PUT IN	PULLED OUT
Lansing	Dry	3596	3857	8 5/8	245	None
Mississippi	Dry	3929	4004	5 1/2	4225	3140'
Viola	Dry	4004	4138			
Simpson Shale	Dry	4138	4144			
Simpson Sand	Dry	4144	4193			
Arbuckle	Dry	4193	4225			

Describe in detail the manner in which the well was plugged, indicating where the mud fluid was placed and the method or methods used in introducing it into the hole. If cement or other plugs were used, state the character of same and depth placed, from feet to feet for each plug set.

Sand 4124-3900  
 5 Sx. Cement 3900-3870  
 Mud 3870- 230  
 Rock Bridge 230- 220  
 20 Sx. Cement 220- 160  
 Mud 160- 40  
 Rock and 10 Sx. Cement 40 to cellar base

STATE CORPORATION COMMISSION  
OCT 3 1962

10-8-1962

(If additional description is necessary, use BACK of this sheet)  
Name of Plugging Contractor Glenn and Smith Pipe Pulling Co.  
Address P. O. Box 114, Ellinwood, Kansas

STATE OF Kansas, COUNTY OF Barton, ss.  
H. E. Wolfe (employee of owner) or (owner or operator) of the above-described well, being first duly sworn on oath, says: That I have knowledge of the facts, statements, and matters herein contained and the log of the above-described well as filed and that the same are true and correct. So help me God.

(Signature) H. E. Wolfe  
P. O. Box 488 - 3 Ellinwood Kansas  
(Address)

SUBSCRIBED AND SWORN to before me this 4th day of October, 1962

Notary Public

My commission expires 8-21-65

