


STATE OF KANSAS  
STATE CORPORATION COMMISSION

WELL PLUGGING RECORD

Give All Information Completely  
Make Required Affidavit  
Mail or Deliver Report to:  
Conservation Division  
State Corporation Commission  
211 No. Broadway  
Wichita, Kansas

NORTH

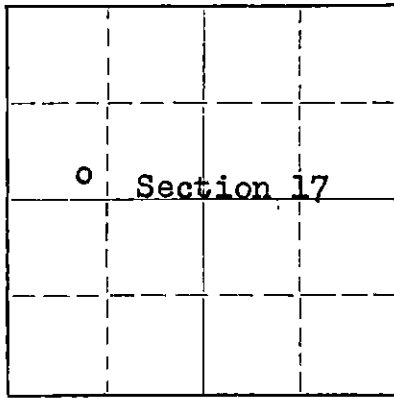

Locate well correctly on above  
Section Plat

Stafford County. Sec. 17 Twp. 24 Rge. 13 (X) W (W)  
Location as "NE/CNW/SW" or footage from lines SE SW NW  
Lease Owner Petroleum, Inc.  
Lease Name Roenbaugh Well No. 1  
Office Address Route 2, Great Bend, Kansas  
Character of Well (completed as Oil, Gas or Dry Hole) Dry hole  
Date well completed August 13 19 58  
Application for plugging filed August 13 19 58  
Application for plugging approved August 13 19 58  
Plugging commenced August 13 19 58  
Plugging completed August 13 19 58  
Reason for abandonment of well or producing formation No producible zones

If a producing well is abandoned, date of last production None 19       
Was permission obtained from the Conservation Division or its agents before plugging was commenced? Yes

Name of Conservation Agent who supervised plugging of this well FRANK BROADFOOT  
Producing formation ----- Depth to top ---- Bottom ----- Total Depth of Well 4225 Feet  
Show depth and thickness of all water, oil and gas formations.

OIL, GAS OR WATER RECORDS

CASING RECORD

| FORMATION | CONTENT | FROM | TO | SIZE   | PUT IN | PULLED OUT |
|-----------|---------|------|----|--------|--------|------------|
|           |         |      |    | 8 5/8" | 245'   | None       |
|           |         |      |    |        |        |            |
|           |         |      |    |        |        |            |
Describe in detail the manner in which the well was plugged, indicating where the mud fluid was placed and the method or methods used in introducing it into the hole. If cement or other plugs were used, state the character of same and depth placed, from      feet to      feet for each plug set.

Mud up with heavy mud to 210' followed by a wooden plug and 1/4 sack hulls. Placed 20 sacks cement through drill pipe on to plug. Mud up to 35' followed by a wooden plug and 1/4 sack hulls. Filled hole to base of well cellar with 10 sacks cement.

8-28-58

(If additional description is necessary, use BACK of this sheet)  
Name of Plugging Contractor Garvey Drilling Co.  
Address Route 2, Great Bend, Kansas

STATE OF Kansas, COUNTY OF Barton, ss.  
Don Searle (employee of owner) or (~~owner~~) of the above-described well, being first duly sworn on oath, says: That I have knowledge of the facts, statements, and matters herein contained and the log of the above-described well as filed and that the same are true and correct. So help me God.

(Signature) Don Searle  
Route 2, Great Bend, Kansas  
(Address)

SUBSCRIBED AND SWORN TO before me this 26th day of August, 1958  
      
Notary Public.

My commission expires July 11, 1960

PLUGGING  
FILE SEC. 17 T. 24 R. 13  
BOOK PAGE 123 LINE 15

15-185-00486-0000  
WELL LOG

COMPANY Petroleum, Inc.

SEC. 17 T. 24 R. 13W

FARM ROEMBAUGH

NO. 1

LOC. SE SW NW


TOTAL DEPTH 4225'

COUNTY Stafford

COMM. August 3, 1958

COMP. August 12, 1958

CONTRACTOR Garvey Drilling Company

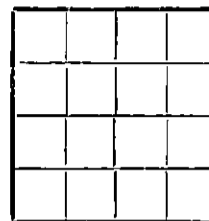

CASING 8-5/8" @ 245' w/200 sax

ELEVATION 1927' DF

PRODUCTION Plugged & Abandoned

FIGURES INDICATE BOTTOM OF FORMATIONS

|      |                     |
|------|---------------------|
| 150  | Sand                |
| 216  | Blue Shale          |
| 247  | Red Bed             |
| 815  | Red Bed & Shale     |
| 835  | Anhydrite           |
| 1240 | Shale & Shells      |
| 2270 | Lime                |
| 3370 | Lime & Shale        |
| 3452 | Lime                |
| 3535 | Shale & Lime        |
| 3600 | Lime & Shale        |
| 3948 | Lime                |
| 3997 | Cherty Lime & Shale |
| 4159 | Cherty Lime         |
| 4225 | Lime                |

RTD 4225'

C

8-28-58

CONSERVATION  

|           |                 |
|-----------|-----------------|
| PLUGGING  |                 |
| FILE SEC. | 17 T. 24 R. 13W |
| BOOK PAGE | 123 LINES       |

State of KANSAS }  
County of BARTON } ss:

I, Verne A. Morris of Garvey Drilling Company

upon oath state that the above and foregoing is a true and correct copy of the log of the ROEMBAUGH #1 well

Verne A. Morris

Subscribed and sworn to before me this 25th day of August 19 58

My Commission Expires: July 11, 1960

[Signature]  
NOTARY PUBLIC