


WELL PLUGGING RECORD

Information Completely  
Required Affidavit  
or Deliver Report to:  
Conservation Division  
State Corporation Commission  
211 No. Broadway  
Wichita, Kansas

Stafford County, Sec. 17 Twp. 24 Rge. 13 (E) (W) X

Location as "NE/CNW/SW" or footage from lines NE SW SW  
Lease Owner Petroleum Inc.  
Lease Name Harrison "B" Well No. #1  
Office Address Route #2, Great Bend, Kansas  
Character of Well (completed as Oil, Gas or Dry Hole) \_\_\_\_\_  
Date well completed \_\_\_\_\_ 19\_\_\_\_  
Application for plugging filed \_\_\_\_\_ 19\_\_\_\_  
Application for plugging approved \_\_\_\_\_ 19\_\_\_\_  
Plugging commenced 5-10-63 \_\_\_\_\_ 19\_\_\_\_  
Plugging completed 5-14-63 \_\_\_\_\_ 19\_\_\_\_  
Reason for abandonment of well or producing formation \_\_\_\_\_

NORTH

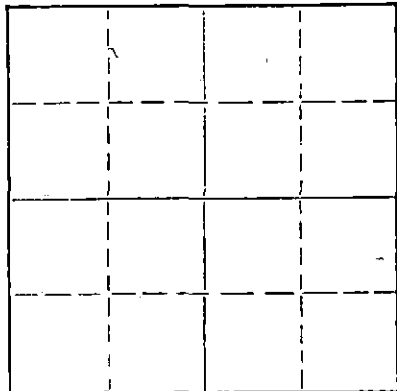

Locate well correctly on above  
Section Plat

If a producing well is abandoned, date of last production \_\_\_\_\_ 19\_\_\_\_  
Was permission obtained from the Conservation Division or its agents before plugging was commenced? \_\_\_\_\_

Name of Conservation Agent who supervised plugging of this well Archie V. Elving  
Producing formation \_\_\_\_\_ Depth to top \_\_\_\_\_ Bottom \_\_\_\_\_ Total Depth of Well 4210' Feet  
Show depth and thickness of all water, oil and gas formations.

OIL, GAS OR WATER RECORDS

CASING RECORD

FORMATION	CONTENT	FROM	TO	SIZE	PUT IN	PULLED OUT

Describe in detail the manner in which the well was plugged, indicating where the mud fluid was placed and the method or methods used in introducing it into the hole. If cement or other plugs were used, state the character of same and depth placed, from \_\_\_\_\_ feet to \_\_\_\_\_ feet for each plug set.

Sanded back to 3640', mixed and ran 5 sacks cement thru dump baler.  
Squeezed hole with 20 sacks gel and 65 sacks cement by Globe Oilwell Cementing  
Found cement at 80' - Mudded hole to 35' and sat 10' rock bridge, mixed and dumped  
8 sacks cement to base of cellar.

RECEIVED  
STATE CORPORATION COMMISSION

MAY 15 1963

CONS. DIV.  
WICHITA, KANSAS

(If additional description is necessary, use BACK of this sheet)

Name of Plugging Contractor Southwest Casing Pulling Co., Inc.  
Address Box 364, Great Bend, Kansas

STATE OF Kansas, COUNTY OF Barton, ss.  
Southwest Casing Pulling Co., Inc. (employee of owner) or (owner or operator) of the above-described well, being first duly sworn on oath, says: That I have knowledge of the facts, statements, and matters herein contained and the log of the above-described well as filed and that the same are true and correct. So help me God.

(Signature) W. C. Spencer Secy.  
Box 364, Great Bend, Kansas  
(Address)

SUBSCRIBED AND SWORN TO before me this 14 day of May, 19 63

commission expires 24 October 1964

Sidney D. Miller  
Notary Public.

INVOICED

DATE 5/15/63  
INV. NO. 9082-W

# WELL LOG

COMPANY PETROLEUM, INCORPORATED

SEC. 17 T. 24S R. 13W

FARM HARRISON "B" NO. 1

LOC. NE, SW, SW


TOTAL DEPTH 4210'

COUNTY STAFFORD CO., KANSAS

COMM. May 10, 1958

COMP. May 23, 1958

CONTRACTOR GARVEY DRILLING COMPANY

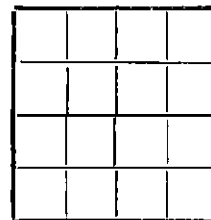

CASING 8 5/8" @ 246.77' W/200 sax.  
5 1/2" @ 3990' W/150 sax.

ELEVATION 1932' DF

PRODUCTION Kansas City

FIGURES INDICATE BOTTOM OF FORMATIONS

45	Surface soil & sand
247	Sand & shale
800	Shale & shells
835	Anhydrite
1785	Shale & shells
2000	Shale, shells & lime
2200	Lime
3350	Shale & lime
3578	Lime & shale
3905	Lime
3920	Chert
3975	Shale
4000	Lime
4037	Chert
4094	Cherty lime
4124	Chert
4165	Lime & shale
4210	Arbuckle lime
4210	T. D.

RECEIVED  
STATE CORPORATION COMMISSION

MAY 23 1963

CONSERVATION DIVISION  
Wichita, Kansas

State of KANSAS }  
County of BARTON } ss:

I, VERNE A. MORRIS of GARVEY DRILLING COMPANY

upon oath state that the above and foregoing is a true and correct copy of the log of the #1 HARRISON "B" well

*Verne A. Morris*

Subscribed and sworn to before me this 6th day of August 19 58

My Commission Expires: July 11, 1960

*Jed A. Brown*  
NOTARY PUBLIC