


STATE OF KANSAS
STATE CORPORATION COMMISSION

Give All Information Completely
Make Required Affidavit
Mail or Deliver Report to:
Conservation Division
State Corporation Commission
211 No. Broadway
Wichita, Kansas

WELL PLUGGING RECORD

NORTH

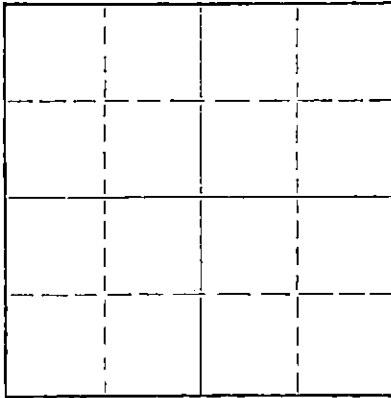

Locate well correctly on above
Section Plat

Stafford County, Sec. 15 Twp. 24S Rge. 13W (E) (W)

Location as "NE/CNW%SW%" or footage from lines SW SE NW

Lease Owner Sterling Drilling Company

Lease Name Soden Well No. "A" #1

Office Address Box 127, Sterling, Kansas

Character of Well (completed as Oil, Gas or Dry Hole) Dry Hole

Date well completed 9-25 19 61

Application for plugging filed 9-25 19 61

Application for plugging approved 9-25 19 61

Plugging commenced 9-25 19 61

Plugging completed 9-25 19 61

Reason for abandonment of well or producing formation
Completed as dry hole.

If a producing well is abandoned, date of last production 19

Was permission obtained from the Conservation Division or its agents before plugging was commenced? Yes

Name of Conservation Agent who supervised plugging of this well Fred Hampel

Producing formation Depth to top Bottom Total Depth of Well 4125 Feet

Show depth and thickness of all water, oil and gas formations.

OIL, GAS OR WATER RECORDS

CASING RECORD

FORMATION	CONTENT	FROM	TO	SIZE	PUT IN	PULLED OUT
Red Bed				8 5/8"	342'	

Describe in detail the manner in which the well was plugged, indicating where the mud fluid was placed and the method or methods used in introducing it into the hole. If cement or other plugs were used, state the character of same and depth placed, from feet to feet for each plug set.

Filled hole with heavy mud through drill pipe to 240', Halliburton plug and hulls at 240' and 20 sacks cement.
Heavy mud up to 35', Halliburton plug and hulls at 35' and 10 sacks of cement to base of cellar.
Two sacks of cement in rat hole.

10-2-61

(If additional description is necessary, use BACK of this sheet)

Name of Plugging Contractor Sterling Drilling Company

Address Box 127, Sterling, Kansas

STATE OF Kansas, COUNTY OF Rice, ss.

F. A. Wuellner, Secretary (employee of owner) or (owner or operator) of the above-described well, being first duly sworn on oath, says: That I have knowledge of the facts, statements, and matters herein contained and the log of the above-described well as filed and that the same are true and correct. So help me God. STERLING DRILLING COMPANY

(Signature) By: F. A. Wuellner, Secretary Sterling, Kansas (Address)

SUBSCRIBED AND SWORN to before me this 26th day of September, 19 61

My Commission Expires Jan. 22, 1962

Bernard Landersmith Notary Public.



STERLING DRILLING COMPANY
Sterling Kansas

WELL LOG SODEN "A" #1
Located SW 1/4 NW Section 15-24S-13W, Stafford County, Kansas

OWNER: Sterling Drilling Company
ROTARY DRILLING CONTRACTOR: Sterling Drilling Company

COMMENCED: 9-11-61
COMPLETED: 9-25-61

ROTARY TOTAL DEPTH: 4125'

LOG

0 -	15'	Clay & Sand
15'	31 1/2'	Red Bed
31 1/2'	760'	Shale & Red Bed
760'	785'	Anhydrite
785'	925'	Shale & Salt
925'	1705'	Shale
1705'	1765'	Shale & Shells
1765'	2285'	Lime
2285'	2530'	Lime & Shale
2530'	2760'	Lime
2760'	3030'	Lime & Shale
3030'	3565'	Lime
3565'	3695'	Landing - Kansas City
3695'	3925'	Lime
3925'	3955'	Lime & Chert
3955'	4010'	Wells
4010'	4035'	Lime & Chert
4035'	4125'	Lime & Anhydrite

T. D.

CASING RECORD

Set 8-5/8" surface casing
@ 3 1/2" K.B. with 300 sacks
HA-5 cement

Plugged and abandoned