


STATE OF KANSAS  
STATE CORPORATION COMMISSION

Form CP-4

WELL PLUGGING RECORD

Give All Information Completely  
Make Required Affidavit  
Mail or Deliver Report to:  
Conservation Division  
State Corporation Commission  
212 No. Market  
Wichita, Kansas 67202

NORTH

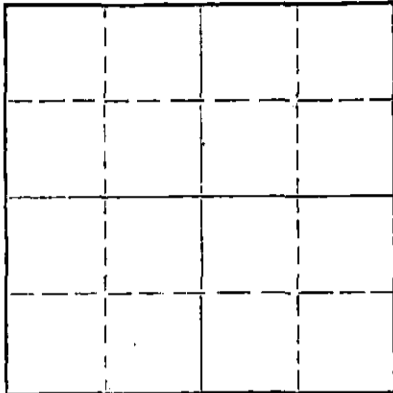

Locate well correctly on above  
Section Plat

Stafford County. Sec. 29 Twp. 24 Rge. 14 (E) W (W)  
Location as "NE/CNW\*SW\*" or footage from lines SW SW SW  
Lease Owner Pickrell Drilling Co.  
Lease Name Sparks C Well No. 1  
Office Address 705 Fourth National Bank Bldg., Wichita, Kansas  
Character of Well (completed as Oil, Gas or Dry Hole) \_\_\_\_\_  
Date well completed June 30 1971  
Application for plugging filed June 17 1971  
Application for plugging approved June 18 1971  
Plugging commenced June 18 1971  
Plugging completed June 30 1971  
Reason for abandonment of well or producing formation Dry Hole

If a producing well is abandoned, date of last production \_\_\_\_\_ 19\_\_\_\_  
Was permission obtained from the Conservation Division or its agents before plugging was commenced? Yes

Name of Conservation Agent who supervised plugging of this well Russell Birenstein  
Producing formation \_\_\_\_\_ Depth to top \_\_\_\_\_ Bottom \_\_\_\_\_ Total Depth of Well 4377 Feet  
Show depth and thickness of all water, oil and gas formations.

OIL, GAS OR WATER RECORDS

CASING RECORD

FORMATION	CONTENT	FROM	TO	SIZE	PUT IN	PULLED OUT
				8 5/8	277	None
				5 1/2	4369	2228

RECEIVED  
STATE CORPORATION COMMISSION  
JUL 22 1971  
CONSERVATION DIVISION  
Wichita, Kansas

Describe in detail the manner in which the well was plugged, indicating where the mud fluid was placed and the method or methods used in introducing it into the hole. If cement or other plugs were used, state the character of same and depth placed, from \_\_\_\_\_ feet to \_\_\_\_\_ feet for each plug set.

June 18, 1971 Plug off bottom. Dumped sand to 4000'. Mix and dumped 5 sacks cement to 3960'.  
June 30, 1971 Plug off top. Globe Oil Well Cementing Co. Mixed and pumped down 8 5/8" surface casing. 2 sacks hulls, 15 sacks gel., release plug, and 100 sacks cement.

(If additional description is necessary, use BACK of this sheet)

Name of Plugging Contractor Russ Casing Pulling, Inc.  
Address P. O. Box 1082, Great Bend, Kansas 67530

STATE OF KANSAS, COUNTY OF SEDGWICK, ss.  
Dale M. Robinson (employee of owner) or (owner or operator) of the above-described well, being first duly sworn on oath, says: That I have knowledge of the facts, statements, and matters herein contained and the log of the above-described well as filed and that the same are true and correct. So help me God.

(Signature) Dale M. Robinson  
705 Fourth Nat'l. Bank Bldg., Wichita, Ks. 67202  
(Address)

SUBSCRIBED AND SWORN to before me this 21st day of July, 1971

Helen L. Martin  
Helen L. Martin Notary Public.

My commission expires August 19, 1971

15-185-20358-0000  
**ROTARY DRILLING LOG**

COMPANY: Pickrell Drilling Company  
 705 Fourth National Bank Building  
 Wichita, Kansas 67202

Rotary Drilling Commenced 5/28/71

Rotary Drilling Completed 6/9/71

LOCATION: Sparks "C" No. 1, SW SW SW Section 29-24S-14W,  
 Stafford County, Kansas

CONTRACTOR: **PICKRELL DRILLING COMPANY**  
 Wichita, Kansas

CASING RECORD: Run 7 Jts. 8-5/8" surface casing set @ 272' KB. Cemented with  
 225 sacks. Completed 5:00 P.M. Circulated.

Ran 130 Jts. 5-1/2" casing set @ 4369'. Cemented with 125 sacks  
 common. Plug down at 4:50 A.M. June 9, 1971.

**LOG**

(Figures indicate bottom of formation — measurements from top of rotary bushing.)

	<u>C.F.S.</u>
40	3775
160	3786
210	3815
944	3930
961	3961
1800	4135
1880	4295
2000	4377
2125	
2350	
2510	
2635	
2980	
3150	
3315	
3450	
3615	
3730	
3786	
3900	
4017	
4113	
4178	
4202	
4243	
4292	
4323	
4363	
4369	
4377	

	<u>Slope Tests</u>
	2000
	2500
	3000
	3500
	4000

RECEIVED  
 STATE CORPORATION COMMISSION  
 JUN 18 1971  
 CONSERVATION DIVISION  
 Wichita, Kansas

The undersigned, C. W. Sebitts, Attorney-in-Fact for PICKRELL DRILLING COMPANY, hereby certifies in behalf of said Company, that the above is a true and correct log of the formation encountered in drilling the above well as reflected by the Daily Drilling Reports.

PICKRELL DRILLING COMPANY  
 By [Signature]  
 C. W. Sebitts Attorney-in-Fact

STATE OF KANSAS }  
 COUNTY OF SEDGWICK } ss.:

On this 14th day of June, 1971, before me the undersigned, a Notary Public, in and for

the County and State aforesaid, personally appeared C. W. Sebitts, to me known to be the identical person who subscribed the name of PICKRELL DRILLING COMPANY to the foregoing instrument as its Attorney-in-Fact and acknowledged to me that he executed the same as his free and voluntary act and deed, and as the free and voluntary act and deed of such company, for the uses and purposes therein set forth.

Given under my hand and seal of office the day and year last above written.

My commission expires: January 19, 1973

[Signature]  
 Esther Lamone Notary Public

