

Give All Information Completely
Make Required Affidavit
Mail or Deliver Report to:
Conservation Division
State Corporation Commission
211 No. Broadway
Wichita, Kansas

WELL PLUGGING RECORD

Stafford County. Sec. 33 Twp. 24 Rge. 13W (E)____(W)

Location as "NE/CNW/SW" or footage from lines SW NW SE

Lease Owner Beardmore Drilling Company

Lease Name Mitchell Well No. 1

Office Address 827 Beacon Building, Wichita, Kansas 67202

Character of Well (completed as Oil, Gas or Dry Hole) Dry Hole

Date well completed May 14 1964

Application for plugging filed May 14 1964

Application for plugging approved May 14 1964


Plugging commenced May 14 1964

Plugging completed May 14 1964

Reason for abandonment of well or producing formation Dry Hole

If a producing well is abandoned, date of last production _____ 19____

Was permission obtained from the Conservation Division or its agents before plugging was commenced? Yes

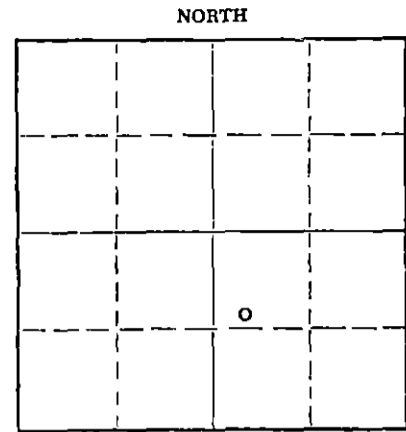

Locate well correctly on above
Section Plat

Name of Conservation Agent who supervised plugging of this well Archie V. Elving, Pratt, Kansas

Producing formation _____ Depth to top _____ Bottom _____ Total Depth of Well _____ Feet

Show depth and thickness of all water, oil and gas formations.

OIL, GAS OR WATER RECORDS

CASING RECORD

FORMATION	CONTENT	FROM	TO	SIZE	PUT IN	PULLED OUT
		0	335'	8 5/8"	335'	None

Describe in detail the manner in which the well was plugged, indicating where the mud fluid was placed and the method or methods used in introducing it into the hole. If cement or other plugs were used, state the character of same and depth placed, from _____ feet to _____ feet for each plug set.

Set Plug @ 275'/25 sacks cement, 1/4 sack hulls
40'/10 sacks cement, 1/4 sack hulls

RECEIVED
STATE CORPORATION COMMISSION

MAY 28 1964

CONSERVATION DIVISION
Wichita, Kansas

Name of Plugging Contractor Hellar Drilling Company, Inc.
Address 1014 Union Center, Wichita, Kansas 67202

STATE OF Kansas COUNTY OF Sedgwick, ss.
D. L. Hellar, Pres. of Hellar Drilling Co., Inc. (employee of owner) or (owner or operator) of the above-described well, being first duly sworn on oath, says: That I have knowledge of the facts, statements, and matters herein contained and the log of the above-described well as filed and that the same are true and correct. So help me God.

(Signature) [Signature] D. L. Hellar, President
1014 Union Center, Wichita, Kansas 67202
(Address)

SUBSCRIBED AND SWORN TO before me this 22nd day of May, 1964

My commission expires March 25, 1968

Catherine Darcey
Catherine Darcey - Notary Public.

DRILLER'S LOG

COMPANY: Beardmore Drilling Company
 CONTRACTOR: Hellar Drilling Company, Inc.
 LEASE: #1 Mitchell
 LOCATION: SW NW SE 33-24-13W, Stafford County, Kansas
 COMMENCED: May 2, 1964
 COMPLETED: May 14, 1964
 CASING: Set 8 5/8" surface casing @ 335'/275 sacks cement

0-341	Sand, Red Bed, Shale
341-799	Shale & Red Bed
799-818	Anhydrite
818-1750	Shale & Red Bed
1750-1980	Shale & Lime
1980-2171	Lime & Shale
2171-3300	Shale & Lime
3300-3638	Lime & Shale
3638-3703	Lime
3703-3790	L. K.C.
3790-3980	Lime
3980-4020	Shale-chert
4020-4070	Viola
4070-4120	Lime&chert
4120-4148	Lime
4148-4170	Simpson Sand
4170-4202	Lime
4202-4242	Arbuckle
4242	Rotary Total Depth

NOTARY PUBLIC
 STATE OF KANSAS
 MAY 23 1964
 CONSERVATION DIVISION
 STAFFORD COUNTY, KANSAS

Dry and Abandoned

STATE OF KANSAS)
) SS
 COUNTY OF SEDGWICK)

I, D. L. Hellar, do hereby certify that the above and foregoing is a true and correct copy of the log of the #1 Mitchell, located in SW NW SE 33-24-13W, Stafford County, Kansas, as reflected by the files of the Hellar Drilling Company, Inc.

HELLAR DRILLING COMPANY, INC.

By _____
 President - D. L. Hellar

Subscribed and sworn to before me, a Notary Public, in and for Sedgwick County, Kansas, this 22nd day of May, 1964.

My Commission Expires:
 March 25, 1968.

Catherine Darcey
 Notary Public - Catherine Darcey