


Give All Information Completely  
Make Required Affidavit  
Mail or Deliver Report to:  
Conservation Division  
State Corporation Commission  
212 North Market, Insurance Bldg.  
Wichita, Kansas

WELL PLUGGING RECORD

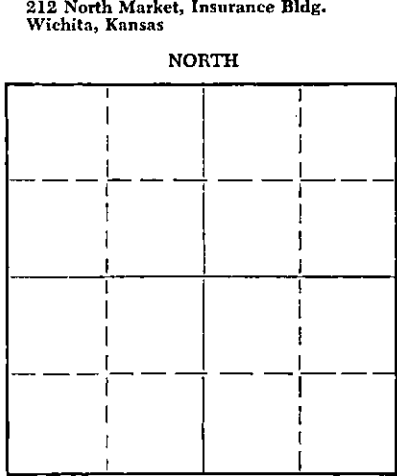

Locate well correctly on above Section Plat

Stafford County. Sec. 33 Twp. 24 Rge. 13W (E) (W)  
Location as "NE/CNW/SW" or footage from lines. SE SE SW  
Lease Owner Hellar Drilling Company, Inc.  
Lease Name Russell Well No. 1  
Office Address 1014 Union Center, Wichita 2, Kansas  
Character of Well (completed as Oil, Gas or Dry Hole) Dry Hole  
Date well completed 1-2 19.60  
Application for plugging filed 1-2 19.60  
Application for plugging approved 1-2 19.60  
Plugging commenced 1-2 19.60  
Plugging completed 1-2 19.60  
Reason for abandonment of well or producing formation Dry Hole

If a producing well is abandoned, date of last production 19  
Was permission obtained from the Conservation Division or its agents before plugging was commenced? Yes

Name of Conservation Agent who supervised plugging of this well Frank Broadfoot  
Producing formation \_\_\_\_\_ Depth to top \_\_\_\_\_ Bottom \_\_\_\_\_ Total Depth of Well 4260 Feet  
Show depth and thickness of all water, oil and gas formations.

OIL, GAS OR WATER RECORDS

CASING RECORD

FORMATION	CONTENT	FROM	TO	SIZE	PUT IN	PULLED OUT
		0	258'	8-5/8"	259.93'	None

Describe in detail the manner in which the well was plugged, indicating where the mud fluid was placed and the method or methods used in introducing it into the hole. If cement or other plugs were used, state the character of same and depth placed, from \_\_\_\_\_ feet to \_\_\_\_\_ feet for each plug set.

Filled hole with mud to 240'. Cemented first plug with 20 sacks cement & 1 sack hulls. Filled to 35' with mud and cemented 2nd plug with 10 sacks cement and 1 sack hulls.

(If additional description is necessary, use BACK of this sheet)

Name of Plugging Contractor Hellar Drilling Company, Inc.  
Address 1014 Union Center, Wichita 2, Kansas

STATE OF KANSAS, COUNTY OF SEDGWICK, ss.  
D. L. Hellar (employee of owner) of the above-described well, being first duly sworn on oath, says: That I have knowledge of the facts, statements, and matters herein contained and the log of the above-described well as filed and that the same are true and correct. So help me God.

(Signature) [Signature]  
1014 Union Center  
(Address)

SUBSCRIBED AND SWORN TO before me this 7th day of January, 1960

My commission expires March 6, 1961. [Signature] Notary Public.



JAN 13 1960

CONSERVATION DIVISION  
Wichita, Kansas

WELL LOG

OWNER: Hellar Drilling Company, Inc.  
 LEASE: Russell #1  
 LOCATION: SE SE SW Sec. 33-24-13W  
 Stafford County, Kansas  
 COMMENCED: December 21, 1959  
 COMPLETED: January 2, 1960  
 CASING: 8-5/8" set @ 258' w/235 sacks  
 cement

0 - 95	Sand
95 - 242	Sand, Shale
242 - 258	Shale
258 - 800	Sand, Shale & Red bed
800 - 1720	Shale
1720 - 2390	Lime & Shale
2390 - 2818	Shale & Lime
2818 - 2880	Lime & Shale
2880 - 2965	Lime, Topeka section
2965 - 3140	Lime
3140 - 3585	Lime & Shale
3585 - 3625	Shale
3625 - 3885	LKC lime
3885 - 4006	Lime
4006 - 4045	Chalky lime, Shale & Chert
4045 - 4092	Conglomerate, Viola
4092 - 4118	Chert, Viola
4118 - 4140	Chert
4140 - 4212	Simpson shale
4212 - 4260	Arbuckle
4260	Rotary Total Depth D & A

STATE OF KANSAS )  
 COUNTY OF SEDGWICK ) SS

I, D. L. Hellar, do hereby certify that the above and foregoing is a true and correct copy of the log of the RUSSELL #1, located in the SE SE SW of Section 33-24-13W, Stafford County, Kansas, as reflected by the files of the HELLAR DRILLING COMPANY, INC.

HELLAR DRILLING COMPANY, INC.

BY

*D. L. Hellar*  
 D. L. Hellar, President

Subscribed and sworn to before me, a Notary Public, in and for Sedgwick County, Kansas, this 7th day of January, 1960.

*Manda Lou Bruce*  
 Notary Public

My commission expires March 6, 1961.