


Give All Information Completely
Make Required Affidavit
Mail or Deliver Report to:
Conservation Division
State Corporation Commission
211 No. Broadway
Wichita, Kansas

WELL PLUGGING RECORD

Stafford County. Sec. 33 Twp. 24S Rge. 13W (E) (W)
Location as "NE/CNW%SW%" or footage from lines NE SE SW
Lease Owner Beardmore Drilling Company
Lease Name Russell Well No. 1
Office Address 827 Beacon Building, Wichita, Kansas 67202
Character of Well (completed as Oil, Gas or Dry Hole) Dry Hole
Date well completed May 1 19 64
Application for plugging filed May 1 19 64
Application for plugging approved May 1 19 64
Plugging commenced May 1 19 64
Plugging completed May 1 19 64
Reason for abandonment of well or producing formation Dry Hole

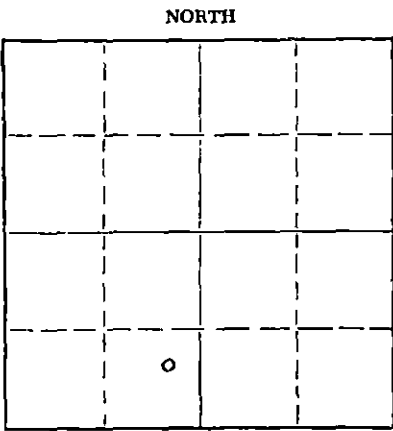

Locate well correctly on above
Section Plat

If a producing well is abandoned, date of last production _____ 19____
Was permission obtained from the Conservation Division or its agents before plugging was com-
menced? Yes

Name of Conservation Agent who supervised plugging of this well Archie V. Elving, Pratt, Kansas
Producing formation _____ Depth to top _____ Bottom _____ Total Depth of Well _____ Feet
Show depth and thickness of all water, oil and gas formations.

OIL, GAS OR WATER RECORDS

CASING RECORD

FORMATION	CONTENT	FROM	TO	SIZE	PUT IN	PULLED OUT
		0	358'	8 5/8"	358'	None

Describe in detail the manner in which the well was plugged, indicating where the mud fluid was placed and the method or methods used in introducing it into the hole. If cement or other plugs were used, state the character of same and depth placed, from _____ feet to _____ feet for each plug set.

Set Plug @ 275'/25 sacks cement, 1/4 sack hulls
40'/10 sacks cement, 1/4 sack hulls

6-17-1964

STATE CORPORATION COMMISSION

JUN 17 1964

CONSERVATION DIVISION
WICHITA, KANSAS

(If additional description is necessary, use BACK of this sheet)
Name of Plugging Contractor Hellar Drilling Company, Inc.
Address 1014 Union Center, Wichita, Kansas 67202

STATE OF Kansas COUNTY OF Sedgwick, ss.
D.L. Hellar, Pres. of Hellar Drilling Co. Inc. (employee of owner) or (owner or operator) of the above-described

well, being first duly sworn on oath, says: That I have knowledge of the facts, statements, and matters herein contained and the log of the above-described well as filed and that the same are true and correct. So help me God.

(Signature) [Signature] D. L. Hellar, President
1014 Union Center, Wichita, Kansas 67202

SUBSCRIBED AND SWORN TO before me this 7th day of May, 19 64

My commission expires March 25, 1968. Catherine Darcey Notary Public.

DRILLER'S LOG

COMPANY: Beardmore Drilling Company
 CONTRACTOR: Hellar Drilling Company
 LEASE: #1 Russell
 LOCATION: NE SE SW 33-24S-13W, Stafford County, Kansas
 COMMENCED: April 21, 1964
 COMPLETED: May 1, 1964
 CASING: Set 8 5/8" surface casing @ 358'/300 sacks cement

0-358	Sand & Shale
358-480	Shale
480-814	Red Bed & Shale
814-831	Anhydrite
831-1250	Red Bed - Shale
1250-1740	Shale & Salt Section
1740-3325	Lime & Shale
3325-3420	Lime
3420-3655	Lime & Shale
3655-3705	K. C.
3705-3850	Lime
3850-3895	K. C. - Lime
3895-3975	Lime
3975	Rotary Total Depth
	Dry and Abandoned

STATE OF KANSAS)
) SS
 COUNTY OF SEDGWICK)

I, D. L. Hellar, do hereby certify that the above and foregoing is a true and correct copy of the log of the #1 Russell, located in NE SE SW 33-24S-13W, Stafford County, Kansas, as reflected by the files of the Hellar Drilling Company, Inc.

HELLAR DRILLING COMPANY, INC.

By _____
 President - D. L. Hellar

Subscribed and sworn to before me, a Notary Public, in and for Sedgwick County, Kansas, this 7th day of May, 1964.

My Commission Expires:
 March 25, 1968.

 Notary Public - Catherine Darcey