

15-185-01318-0000

STATE OF KANSAS  
STATE CORPORATION COMMISSION


WELL PLUGGING RECORD

Give All Information Completely  
Make Required Affidavit  
Mail or Deliver Report to:  
Conservation Division  
State Corporation Commission  
800 Bitting Building  
Wichita, Kansas

OR  
FORMATION PLUGGING RECORD

Strike out upper line  
when reporting plug-  
ging off formations.

NORTH

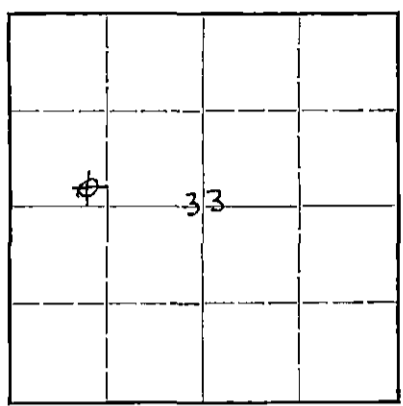

Locate well correctly on above  
Section Plat

Stafford County. Sec. 33 Twp. 24 Rge. 1 (E) 13 (W)  
Location as "NE 1/4 NW 1/4 SW 1/4" or footage from lines. SE SW NW 1/4  
Lease Owner. W. P. Faulkner  
Lease Name. Zelma Kipp Russell Well No. 1  
Office Address. 409 First Nat'l Bk. Bldg., Wichita 2, Kansas  
Character of Well (completed as Oil, Gas or Dry Hole). Dry  
Date well completed. June 26, 1944 19  
Application for plugging filed. June 25, 1944 19  
Application for plugging approved. June 25, 1944 19  
Plugging commenced. June 25, 1944 19  
Plugging completed. June 26, 1944 19  
Reason for abandonment of well or producing formation. Dry Hole

If a producing well is abandoned, date of last production. 19  
Was permission obtained from the Conservation Division or its agents before plugging was com-  
menced? Yes

Name of Conservation Agent who supervised plugging of this well. Eldon Petty  
Producing formation. Arbuckle Depth to top. Bottom. Total Depth of Well. 4240 Feet  
Show depth and thickness of all water, oil and gas formations.

OIL, GAS OR WATER RECORDS

CASING RECORD

Formation	Content	From	To	Size	Put In	Pulled Out
Arbuckle	Dry			10 3/4"		None Recovered

Describe in detail the manner in which the well was plugged, indicating where the mud fluid was placed and the method or methods used in introducing it into the hold. If cement or other plugs were used, state the character of same and depth placed, from \_\_\_\_\_ feet to \_\_\_\_\_ feet for each plug set.  
Well was filled with heavy mud from 4240 to 325. Cement from 325 to 280.  
Mud from 280 to 25 and cement from 25 to 5, bottom of cellar.

FILE 33 24-130  
BOOK 122 PAGE 64

(If additional description is necessary, use BACK of this sheet)  
Correspondence regarding this well should be addressed to W. P. Faulkner  
Address. 409 First National Bank Bldg., Wichita 2, Kansas

STATE OF Kansas, COUNTY OF Sedgwick, ss.  
E. Russell, Secy (employee of owner) or (owner) of the above-described well,  
being first duly sworn on oath, says: That I have knowledge of the facts, statements, and matters herein contained and the log of the above-described well as filed and that the same are true and correct. So help me God.

(Signature) E. Russell  
409 First National Bk. Bldg., Wichita 2, Kansas  
(Address)

SUBSCRIBED AND SWORN TO before me this 18th day of August, 1944.  
Mildred J. Jaeger  
Notary Public.

My commission expires May 5, 1945

Company: Faulkner Oil Company  
 Lease: Russell #1 - SE SW NW Sec. 33-24S-13W  
 County: Stafford  
 Driller: Campbell & Kuhn  
 Well Commenced: May 27, 1944  
 Completed: June 26, 1944  
 Production: Dry

Figures indicate bottom of formations.

Sand & Clay	324
Set 320' 10"	593
Red Bed	820
Anhydrite	855
Shale	893
Shale & shells	1205
Salt Shale	1475
Shale & shells	1725
Shale & Lime	2336
Lime	2390
Lime & Shale	2639
Shale, lime & shells	2725
Shale & Lime	3020
Shale	3050
Shale & Lime	3185
Lime	3360
Shale	3387
Lime	3515
Shale	3632
Lime	3732
Lime & Chirt	3754
Lime	3905
Shale & Lime	3934
Shale	3964
Chirty Lime	3978
Shale	4043
Chirty Lime	4057
Lime	4072
Chirty Lime	4095
Chirt & Shale	4109
Chirty Lime	4124
Lime	4130
Lime	4160
Lime & Shale	4182
Shale	4215
Lime	4238
	4240 - T.D.

3-16-48

