

15-185-01398-0000


STATE OF KANSAS
STATE CORPORATION COMMISSION

Form CP-4

WELL PLUGGING RECORD

Give All Information Completely
Make Required Affidavit
Mail or Deliver Report to:
Conservation Division
State Corporation Commission
212 No. Market
Wichita, Kansas

NORTH

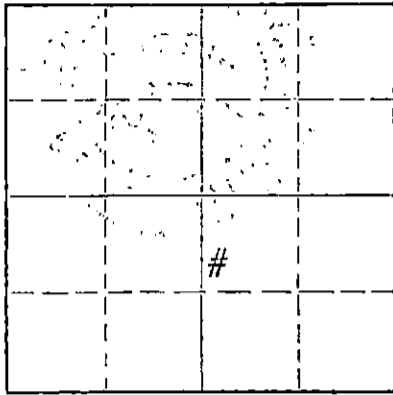

Locate well correctly on above
Section Plat

Stafford County, Sec 33 Twp. 24 Rge. 13 (E) W (W)
Location as "NE/CNW%SW%" or footage from lines NW SW SE
Lease Owner Pickrell Drilling Co.
Lease Name Halley Well No. 1
Office Address 705 Fourth Natl. Bank Bldg. Wichita
Character of Well (completed as Oil, Gas or Dry Hole) Oil
Date well completed Jan. 16, 1964
Application for plugging filed May 29, 1968
Application for plugging approved June 3, 1968
Plugging commenced June 6, 1968
Plugging completed June 12, 1968
Reason for abandonment of well or producing formation Depleted

If a producing well is abandoned, date of last production May 23, 1968
Was permission obtained from the Conservation Division or its agents before plugging was commenced? Yes

Name of Conservation Agent who supervised plugging of this well Ralph Warren
Producing formation Kansas City Depth to top 3615 Bottom 3896 Total Depth of Well 4224 Feet
Show depth and thickness of all water, oil and gas formations.

OIL, GAS OR WATER RECORDS

CASING RECORD

FORMATION	CONTENT	FROM	TO	SIZE	PUT IN	PULLED OUT
				8 5/8	264'	None
				5 1/2	3903'	2117'


Describe in detail the manner in which the well was plugged, indicating where the mud fluid was placed and the method or methods used in introducing it into the hole. If cement or other plugs were used, state the character of same and depth placed, from _____ feet to _____ feet for each plug set.

Plugged back with sand from 3847' to 3700'. Mixed and dumped 5 sx. of cement from 3700' to 3660'. Pulled casing. Mudded hole to 260'. Set 10' rock bridge from 260' to 250'. Mixed and dumped 25 sx. of cement from 250' to 175'. Mudded hole from 175' to 40'. Set 10' rock bridge from 40' to 30'. Mixed and dumped 10 sx. of cement from 30' to base of the cellar.

RECEIVED
STATE CORPORATION COMMISSION
JUN 24 1968
CONSERVATION DIVISION
Wichita, Kansas

(If additional description is necessary, use BACK of this sheet)
Name of Plugging Contractor Russ Casing Pulling Inc.
Address Box 1082 Great Bend, Ks.

STATE OF KANSAS COUNTY OF SEDGWICK, ss.
C. W. Sebitts ~~employee of owner~~ (owner or operator) of the above-described well, being first duly sworn on oath, says: That I have knowledge of the facts, statements, and matters herein contained and the log of the above-described well as filed, and that the same are true and correct. So help me God.

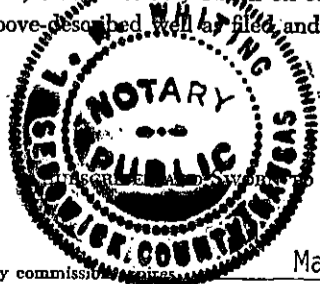

(Signature) C. W. Sebitts
705 4th Nat'l Bank Bldg., Wichita, Ks. 67202
(Address)

before me this 20th day of June, 19 68
L. M. Whiting
L. M. Whiting Notary Public.

My commission expires May 10, 1970

15-185-01398-0000

DRILLER'S LOG

COMPANY: Deardmore Drilling Company
 CONTRACTOR: Heller Drilling Company, Inc.
 LEASE: #1 Halley
 LOCATION: NW SW SE 33-24S-13W
 Stafford County, Kansas
 COMMENCED: January 2, 1964
 COMPLETED: January 16, 1964
 CASING: Set 3 5/8" surface casing @ 264'/225 sacks cement
 Set 5 1/2" casing @ 3910'/75 sacks cement

0-264	Sand & shale
264-850	Shale-Sand & Red Beds
850-1447	Shale & Red Beds
1447-1903	Salt Section
1908-2270	Ft. Riley
2270-3027	Shale & Lime
3027-3634	Lime & Shale
3634-3688	Lsg.-K.C.
3688-3700	Lime
3700-3765	Lsg.-K.C.
3765-3804	Lime
3804-3818	Lsg.-K.C.
3818-3870	Lime
3870-3930	Marmaton Section
3930-3986	Cong.-Miss. & Kind.
3986-4015	Shale & chert
4015-4041	Lime & chert
4041-4084	Viola
4084-4114	Lime & chert
4114-4139	Viola
4139-4165	Viola & Simpson
4165-4191	Shale/lime
4191-4216	Simpson & Arbuckle
4216-4226	Arbuckle
4226	Rotary Total Depth

RECEIVED
 STATE CORPORATION COMMISSION
 JUN 3 1964
 CONSERVATION DIVISION
 Wichita, Kansas

STATE OF KANSAS)
) ss
 COUNTY OF SEDGWICK)

I, D. L. Heller, do hereby certify that the above and foregoing is a true and correct copy of the log of the #1 Halley, located in NW SW SE 33-24S-13W, Stafford County, Kansas, as reflected by the files of the Heller Drilling Company, Inc.

HELLAR DRILLING COMPANY, INC.

By _____
 President - D. L. Heller

Subscribed and sworn to before me, a Notary Public, in and for Sedgwick County, Kansas, this 2nd day of February 1964.

My Commission Expires: March 25, 1964.

 Notary Public - Catherine Darcey