


STATE OF KANSAS
STATE CORPORATION COMMISSION

Form CP-4

Give All Information Completely
Make Required Affidavit
Mail or Deliver Report to:
Conservation Division
State Corporation Commission
211 No. Broadway
Wichita, Kansas

WELL PLUGGING RECORD

NORTH

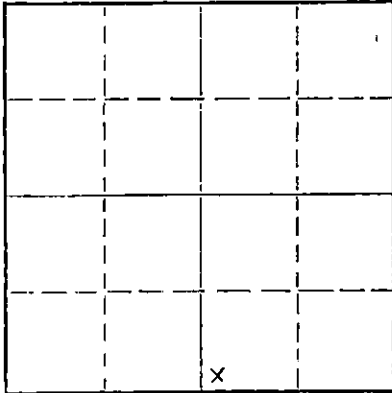

Locate well correctly on above
Section Plat

Stafford County. Sec. 34 Twp. 24S Rge. (E) 13 (W)

Location as "NE/CNW/SW" or footage from lines

Lease Owner Tenneco Oil CompanyLease Name C. KirkpatrickWell No. 1Office Address 2000 Classen Building, Oklahoma City, Oklahoma

Character of Well (completed as Oil, Gas or Dry Hole)

Dry Hole

Date well completed

3-11 19 66

Application for plugging filed

3-16 19 66

Application for plugging approved

3-14 19 66

Plugging commenced

3-11 19 66

Plugging completed

3-11 19 66

Reason for abandonment of well or producing formation

Dry Hole

If a producing well is abandoned, date of last production

19Was permission obtained from the Conservation Division or its agents before plugging was commenced? Yes

Name of Conservation Agent who supervised plugging of this well

ElvingProducing formation None

Depth to top

Bottom

Total Depth of Well 3962 Feet

Show depth and thickness of all water, oil and gas formations.

OIL, GAS OR WATER RECORDS

CASING RECORD

FORMATION	CONTENT	FROM	TO	SIZE	PUT IN	PULLED OUT
				8-5/8	243'	-0-

Describe in detail the manner in which the well was plugged, indicating where the mud fluid was placed and the method or methods used in introducing it into the hole. If cement or other plugs were used, state the character of same and depth placed, from _____ feet to _____ feet for each plug set.

Mudded up to 225 ft., set plug with hulls and cemented with 25 sacks,
mudded to 40 ft., set bridge plug with 10 sacks of cement up to collars.
Set 2 sacks in rat hole.

(If additional description is necessary, use BACK of this sheet)
Name of Plugging Contractor Tenneco Oil Company

Address 2000 Classen Building, Oklahoma City, OklahomaSTATE OF OKLAHOMA, COUNTY OF OKLAHOMA, ss.

John G. Lemons (employee of owner) or (owner or operator) of the above-described well, being first duly sworn on oath, says: That I have knowledge of the facts, statements, and matters herein contained and the log of the above-described well as filed and that the same are true and correct. So help me, God.

(Signature) John G. Lemons District Office Supt.

(Address)

SUBSCRIBED AND SWORN TO before me this 21 day of March, 19 66My commission expires 5/24/68

Notary Public.

WELL LOG

Tenneco Oil Company &
Burch Exploration, Inc.
#1 Kirkpatrick
SW SW SE of Sec. 34-24S-13W
Stafford County, Kansas

Set 8-5/8" @ 243' with 225 sacks Posmix.
Commenced: 3-2-66
Completed: 3-10-66
Elevation: 1939 KB

D & A


130 Sand & Gravel
166 Shale
1135 Red Bed
1585 Red & Shale
1830 Shale & Shells
2050 Lime
2609 Shale & Lime
2957 Shale & Shells
3109 Shale
3722 Shale & Lime
3829 Lime
3962 Lime & Shale

3962 Rotary Total Depth

	<u>Tops</u>
Heebner	3493 (-1554)
Toronto	3512 (-1573)
Brown Limestone	3642 (-1703)
Lansing Kansas City	3664 (-1725)
Base Kansas City	3946 (-2007)

STATE OF KANSAS)
) ss:
COUNTY OF SEDGWICK)

I, Earl M. Burch, President of Burch Exploration, Inc. being duly sworn on oath, state: That I have knowledge of the facts, statements and matters herein contained and that the same are true and correct.


Earl M. Burch, President

Subscribed and sworn to before me this 16th day of March, 1966.

Minnie E. Matson, Notary Public

My commission expires: June 18, 1968