

15-185-30361-0000

STATE OF KANSAS  
STATE CORPORATION COMMISSION

Form CP-4


Give All Information Completely  
Make Required Affidavit  
Mail or Deliver Report to:  
Conservation Division  
State Corporation Commission  
211 No. Broadway  
Wichita, Kansas

WELL PLUGGING RECORD

Stafford County, Sec. 34 Twp. 24S Rge. 13W (E) (W)

Location as "NE/CNW%SW%" or footage from lines N/2 SE/4 SW/4  
Lease Owner Hellar Drilling Company, Inc.  
Lease Name Halley "A" Well No. 2  
Office Address 1014 Union Center, Wichita, Kansas 67202  
Character of Well (completed as Oil, Gas or Dry Hole) Dry Hole  
Date well completed December 14 19 66  
Application for plugging filed December 14 19 66  
Application for plugging approved December 14 19 66  
Plugging commenced December 14 19 66  
Plugging completed December 14 19 66  
Reason for abandonment of well or producing formation Dry Hole

NORTH

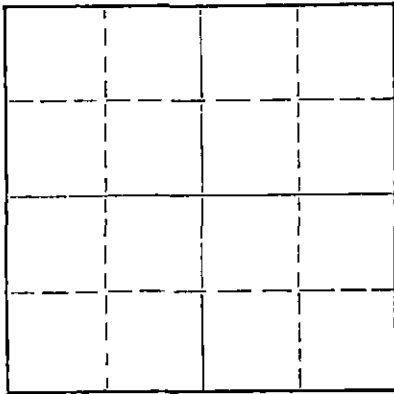

Locate well correctly on above  
Section Plat

If a producing well is abandoned, date of last production 19\_\_\_\_  
Was permission obtained from the Conservation Division or its agents before plugging was commenced? Yes

Name of Conservation Agent who supervised plugging of this well A. Elving, Box 248, Pratt, Kansas  
Producing formation \_\_\_\_\_ Depth to top \_\_\_\_\_ Bottom \_\_\_\_\_ Total Depth of Well 3892 Feet  
Show depth and thickness of all water, oil and gas formations.

OIL, GAS OR WATER RECORDS

CASING RECORD

FORMATION	CONTENT	FROM	TO	SIZE	PUT IN	PULLED OUT
		0	248'	8 5/8"	248'	None

Describe in detail the manner in which the well was plugged, indicating where the mud fluid was placed and the method or methods used in introducing it into the hole. If cement or other plugs were used, state the character of same and depth placed, from \_\_\_\_\_ feet to \_\_\_\_\_ feet for each plug set.

Set Plug: 230'/25 sacks cement  
40'/10 sacks cement  
2 sacks cement in rat hole

12-29-66

(If additional description is necessary, use BACK of this sheet)

Name of Plugging Contractor Hellar Drilling Company, Inc.  
Address Wichita, Kansas 1014 Union Center 67202

STATE OF Kansas, COUNTY OF Sedgwick, ss.  
D. L. Hellar, Pres. of Hellar Drilling Company, Inc. (employee of owner) or (owner or operator) of the above-described well, being first duly sworn on oath, says: That I have knowledge of the facts, statements, and matters herein contained and the log of the above-described well as filed and that the same are true and correct. So help me God.

(Signature) D. L. Hellar D. L. Hellar, President  
1014 Union Center, Wichita, Kansas 67202  
(Address)

SUBSCRIBED AND SWORN to before me this 23rd day of December, 19 66

My commission expires March 25, 1968

Catherine Darcey  
Catherine Darcey Notary Public.

DRILLER'S LOG

COMPANY: Hellar Drilling Company, Inc., Wichita, Kansas  
 CONTRACTOR: Hellar Drilling Company, Inc., Wichita, Kansas  
 LEASE: #2 Halley "A"  
 LOCATION: N/2 SE/4 SW/4 34-24S-13W, Stafford County, Kansas  
 COMMENCED: December 6, 1966  
 COMPLETED: December 14, 1966  
 CASING: Set 8 5/8" surface casing @ 248'/250 sacks cement

0-460	Shale & Red Bed
460-807	Red Bed
807-820	Anhydrite
820-1350	Shale & Red Bed
1350-1800	Shale & Shells
1800-1947	Lime & Shale
1947-2062	Ft. Riley Cherty Lime
2062-2267	Lime
2267-2630	Lime & Shale
2630-3617	Shale & Lime
3617-3693	Lsg.K.C. Lime
3693-3865	Lime
3865-3892	K.C. Lime
3892-3892	Rotary Total Depth

RECEIVED  
 DEC 29 1966  
 CONSTRUCTION DIVISION  
 STATE OF KANSAS

STATE OF KANSAS     )  
                           ) SS  
 COUNTY OF SEDGWICK )

I, D. L. Hellar, do hereby certify that the above and foregoing is a true and correct copy of the log of the #2 Halley "A", located in N/2 SE/4 SW/4 Sec. 34-24S-13W, Stafford County, Kansas, as reflected by the files of the Hellar Drilling Company, Inc.

HELLAR DRILLING COMPANY, INC.

By *D. L. Hellar*  
 President - D. L. Hellar

Subscribed and sworn to before me, a Notary Public, in and for Sedgwick County, Kansas, this 23rd day of December, 1966.

*Catherine Darcey*  
 Notary Public - Catherine Darcey

My Commission Expires:  
 March 25, 1968.