

15-185-00681-0000

STATE OF KANSAS
STATE CORPORATION COMMISSION


WELL PLUGGING RECORD

Give All Information Completely
Make Required Affidavit
Mail or Deliver Report to:
Conservation Division
State Corporation Commission
800 Bittling Building
Wichita, Kansas

Stafford County. Sec. 34 Twp. 24S Rge. 13W (E) W (W)

Location as "NE/CNW/SW" or footage from lines NW NW SW
Lease Owner Anschutz Drilling Co., Inc.
Lease Name Halley Well No. 1
Office Address 709 Union National Bank Building
Character of Well (completed as Oil, Gas or Dry Hole) Dry Hole
Date well completed March 10, 1955
Application for plugging filed March 10, 1955
Application for plugging approved March 10, 1955
Plugging commenced March 10, 1955
Plugging completed March 10, 1955
Reason for abandonment of well or producing formation Dry Hole

NORTH

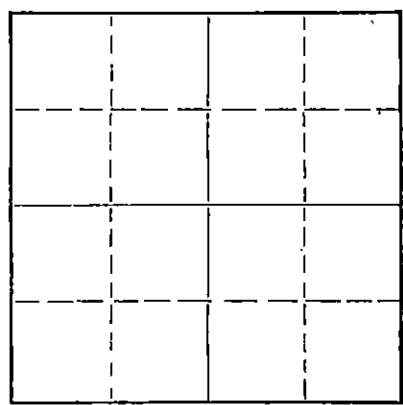

Locate well correctly on above Section Plat

If a producing well is abandoned, date of last production _____ 19____
Was permission obtained from the Conservation Division or its agents before plugging was commenced? Yes

Name of Conservation Agent who supervised plugging of this well M. A. Rives - Pratt, Kansas
Producing formation _____ Depth to top _____ Bottom _____ Total Depth of Well 4246 Feet
Show depth and thickness of all water, oil and gas formations.

OIL, GAS OR WATER RECORDS

CASING RECORD

FORMATION	CONTENT	FROM	TO	SIZE	PUT IN	PULLED OUT
				8 5/8"	316'	None

Describe in detail the manner in which the well was plugged, indicating where the mud fluid was placed and the method or methods used in introducing it into the hole. If cement or other plugs were used, state the character of same and depth placed, from _____ feet to _____ feet for each plug set.

Set Bottom plug at 300' with 20 sacks cement through drill pipe.
Set Top plug at 35' with 10 sacks cement through drill pipe.

3-15-55

(If additional description is necessary, use BACK of this sheet)

Name of Plugging Contractor Anschutz Drilling Co., Inc.
Address 709 Union National Bank Building

STATE OF Kansas COUNTY OF Sedgwick, ss.
E. G. Koelling (employee of owner) or (owner or operator) of the above-described well, being first duly sworn on oath, says: That I have knowledge of the facts, statements, and matters herein contained and the log of the above-described well as filed and that the same are true and correct. So help me God.

(Signature) E. G. Koelling
709 Union National Bank Building
(Address)

SUBSCRIBED AND SWORN TO before me this 10th day of March, 1955

My commission expires July 28, 1958.
Charlene Barbour Notary Public.

PLUGGING
FILE SEC 34 T 24 R 13W
BOOK PAGE 103 LINE 41

D R I L L E R ' S L O G

Anschutz Drilling Co., Inc.
Halley #1
NW NW SW 34-24S-13W
Stafford County, Kansas

<u>TO</u>	<u>FROM</u>	
0	160	Sand
160	550	Red Rock
550	1230	Red Bed & Shale
1230	1675	Shale & Shells
1675	1875	Lime & Shale
1875	1985	Lime
1985	2100	Shale & Lime
2100	2440	Lime & Shale
2440	3310	Shale & Lime
3310	3450	Lime & Shale
3450	3599	Shale & Lime
3599	3646	Lime & Shale
3646	3868	Lime
3868	4006	Lime & Shale
4006	4045	Chert, Lime & Shale
4045	4090	Chert & Lime
4090	4135	Chert, Lime & Shale
4135	4140	Sand
4140	4145	Shale
4145	4170	Simpson
4170	4201	Shale & Lime
4201	4246	Arbuckle
		ROTARY TOTAL DEPTH

COMMENCED: 2-24-55
COMPLETED: 3-10-55

CASING RECORD:

Set 316' of 8 5/8" surface casing with 225 sacks cement.

D & A

STATE OF KANSAS)
) SS
COUNTY OF SEDGWICK)

I hereby affirm that the above and foregoing is a true and correct copy of the log of the Halley #1 located NW NW SW of Section 34-24S-13W, Stafford County, Kansas.

ANSCHUTZ DRILLING CO., INC.

3-15-55

BY: *E. G. Koelling*
E. G. Koelling

Subscribed and sworn to before me this 14th day of March, 1955.

Charlene Barlow
Notary Public

NOTARY PUBLIC
Wichita, Kansas

My Commission Expires: July 28, 1958.

PLUGGING			
FILE	SEC	T	R
ROCK	PAGE	LINE	