


STATE OF KANSAS  
STATE CORPORATION COMMISSION

WELL PLUGGING RECORD

Give All Information Completely  
Make Required Affidavit  
Mail or Deliver Report to:  
Conservation Division  
State Corporation Commission  
211 No. Broadway  
Wichita, Kansas

Stafford County, Sec. 29 Twp. 24S Rge. (E) 13 (W)

Location as "NE/CNW/SW" or footage from lines NW NW NW  
Lease Owner Sterling Drilling Company, et al  
Lease Name Copeland Well No. 1  
Office Address Sterling, Kansas  
Character of Well (completed as Oil, Gas or Dry Hole) Dry Hole  
Date well completed 8-11 19 57  
Application for plugging filed 8-13 19 57  
Application for plugging approved 8-16 19 57  
Plugging commenced 8-26 19 57  
Plugging completed 8-26 19 57  
Reason for abandonment of well or producing formation

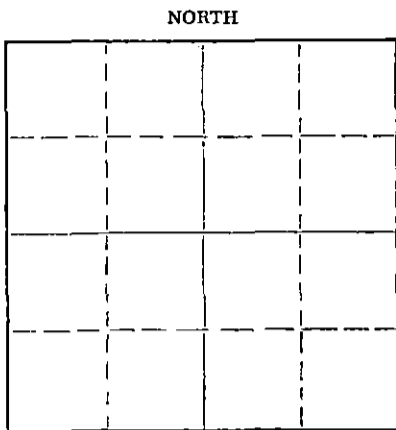

Locate well correctly on above  
Section Plat

If a producing well is abandoned, date of last production 19  
Was permission obtained from the Conservation Division or its agents before plugging was commenced? Yes

Name of Conservation Agent who supervised plugging of this well R. M. Brundage  
Producing formation Depth to top Bottom Total Depth of Well 1173 Feet  
Show depth and thickness of all water, oil and gas formations.

OIL, GAS OR WATER RECORDS

CASING RECORD

FORMATION	CONTENT	FROM	TO	SIZE	PUT IN	PULLED OUT
				8-5/8"	279'	
				5-1/2"	1169'	3729.35'

Describe in detail the manner in which the well was plugged, indicating where the mud fluid was placed and the method or methods used in introducing it into the hole. If cement or other plugs were used, state the character of same and depth placed, from feet to feet for each plug set.

Plugged back with sand to 1155' with 5 sacks cement. Pulled pipe.  
Put in heavy mud. Made rock bridge @ 240', 20 sacks cement in dump  
bailer. Set till morning. Bailed down and tested to see that plug  
was holding. Put in heavy mud up to 20'. Made bridge @ 20' with  
5 sacks cement to 5' below ground level.

9-6-57

(If additional description is necessary, use BACK of this sheet)

Name of Plugging Contractor R & D Well Service  
Address Ellinwood, Kansas

STATE OF KANSAS, COUNTY OF RICE, ss.  
F. A. Wuellner (employee of owner) or (owner or operator) of the above-described well, being first duly sworn on oath, says: That I have knowledge of the facts, statements, and matters herein contained and the log of the above-described well as filed and that the same are true and correct. So help me God.

(Signature) *F. A. Wuellner*  
Sterling, Kansas (Address)

SUBSCRIBED AND SWORN TO before me this 5th day of September, 19 57

*Bernard Laudermilch*  
Notary Public.

My commission expires Jan. 22, 1958

PLUGGING  
FILE SEC 29 T. 24 R. 13W  
BOOK PAGE 37 LINE 7

15-185-00702-0000

STERLING DRILLING COMPANY  
Sterling, Kansas

WELL LOG-----COPELAND #1

Location: NW NW NW, Section 29-24S-13W  
Stafford County, Kansas

OWNER: Sterling Drilling Company, et al  
ROTARY DRILLING CONTRACTOR: Sterling Drilling Company

COMMENCED: 7-10-57 (w.r.)  
COMPLETED: 7-25-57 (w.r.)

TOTAL DEPTH: 4173'

LOG

CASING RECORD

0-140	Sand	
140-830	Shale & Red Bed	
830-865	Anhydrite	
865-1690	Shale & Shells	
1690-1855	Shale & Limestone	
1855-2000	Limestone	
2000-2185	Limestone & Shale	
2185-2375	Limestone	
2375-3555	Limestone & Shale	
3555-4025	Limestone	
4025-4050	Viola Limestone & Chert	
4050-4145	Limestone	
4145-4167	Limestone & Shale	
4167-4173	Limestone	T.D.

Set 8-5/8 inch casing at 279' with  
225 sacks pozmix, 2% calcium chloride.

Set 5-1/2 inch casing at 4169' with  
500 sacks cement.

8-14-57

PLUGGING		
FILE	SEC. 29	T. 24 R. 13W
BOOK	PAGE 37	LINE 7