


15-185-12383-0000

STATE OF KANSAS  
STATE CORPORATION COMMISSION

Give All Information Completely  
Make Required Affidavit  
Mail or Deliver Report to:  
Conservation Division  
State Corporation Commission  
212 North Market, Insurance Bldg.  
Wichita, Kansas

WELL PLUGGING RECORD

STAFFORD County, Sec. 31 Twp. 24s Rge. 13 (#) (W)  
Location as "NE/CNW/SW" or footage from lines W/2 NE SE  
Lease Owner PETROLEUM, INC.  
Lease Name BOWKER "G" Well No. 2  
Office Address ROUTE 2, GREAT BEND, KANSAS  
Character of Well (completed as Oil, Gas or Dry Hole) DRY HOLE  
Date well completed MARCH 18 1961  
Application for plugging filed MARCH 18 1961  
Application for plugging approved MARCH 18 1961  
Plugging commenced MARCH 18 1961  
Plugging completed MARCH 18 1961  
Reason for abandonment of well or producing formation  
NO PRODUCIBLE FORMATIONS  
If a producing well is abandoned, date of last production ----- 19  
Was permission obtained from the Conservation Division or its agents before plugging was commenced? YES

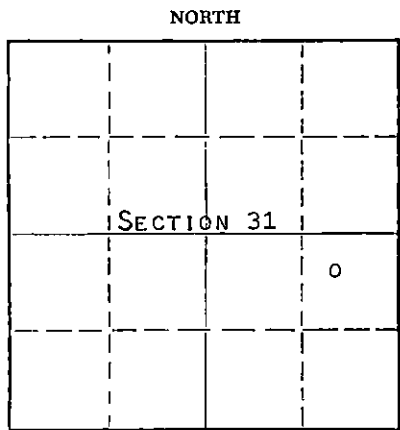

Locate well correctly on above Section Plat

Name of Conservation Agent who supervised plugging of this well FRANK BROADFOOT  
Producing formation \_\_\_\_\_ Depth to top \_\_\_\_\_ Bottom \_\_\_\_\_ Total Depth of Well 4308 Feet  
Show depth and thickness of all water, oil and gas formations.

OIL, GAS OR WATER RECORDS

CASING RECORD

FORMATION	CONTENT	FROM	TO	SIZE	PUT IN	PULLED OUT
				8-5/8"	254'	NONE

Describe in detail the manner in which the well was plugged, indicating where the mud fluid was placed and the method or methods used in introducing it into the hole. If cement or other plugs were used, state the character of same and depth placed, from \_\_\_\_\_ feet to \_\_\_\_\_ feet for each plug set.

MUDDED UP WITH HEAVY MUD TO 240' FOLLOWED BY A WOODEN PLUG AND 1/4 SACK OF HULLS.  
PLACED 20 SACKS OF CEMENT ON TOP OF HULLS THROUGH DRILL PIPE. MUDDED UP WITH HEAVY MUD TO 35' FOLLOWED BY A PLUG AND 1/4 SACK HULLS. PLACED 10 SACKS OF CEMENT ON TOP OF HULLS TO BASE OF WELL CELLAR.

4-4-61

(If additional description is necessary, use BACK of this sheet)

Name of Plugging Contractor GARVEY DRILLING COMPANY  
Address ROUTE 2, GREAT BEND, KANSAS

STATE OF KANSAS, COUNTY OF BARTON, ss.  
DON SEARLE (employee of owner) or (operator) of the above-described well, being first duly sworn on oath, says: That I have knowledge of the facts, statements, and matters herein contained and the log of the above-described well as filed and that the same are true and correct. So help me God.  
(Signature) Don Searle  
ROUTE 2, GREAT BEND, KANSAS (Address)

SUBSCRIBED AND SWORN TO before me this 31ST day of MARCH, 19 61

My commission expires APRIL 14, 1963  
Notary Public.



15-185-12383-0000  
WELL LOG

COMPANY PETROLEUM, INCORPORATED

SEC. 31 T-24S R. 13W

FARM BOWKER "G" NO. 2

LOC. W/2, NE, SE


TOTAL DEPTH 4308'

COUNTY STAFFORD CO., KANSAS

COMM. March 8, 1961

COMP. March 18, 1961

CONTRACTOR GARVEY DRILLING COMPANY

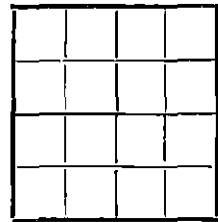

CASING 8 5/8" @ 254' w/225 sax.

ELEVATION 1944' DF

PRODUCTION D & A

FIGURES INDICATE BOTTOM OF FORMATIONS

254	Surface soil & sand
777	Red bed & shale
825	Shale & shells
840	Anhydrite
1750	Shale
1810	Shale & lime
2100	Lime & shale
2310	Lime
2425	Lime & shale
3355	Shale & lime
3445	Lime
3695	Lime & shale
3780	Lime
3850	Lime & shale
3949	Lime
4060	Lime & shale
4080	Lime
4173	Lime & chert
4207	Chert & lime
4289	Shale & lime
4308	Arbuckle lime.
4308	T. D.

½

RECEIVED  
STATE CORPORATION COMMISSION

APR 4 1961

CONSERVATION DIVISION  
Topeka, Kansas

State of KANSAS }  
County of BARTON } ss

I, VERNE A. MORRIS of GARVEY DRILLING COMPANY

upon oath state the above and foregoing is a true and correct copy of the log of the #2 BOWKER "G" well.

Subscribed and sworn to before me this 30 day of March 1961

My Commission Expires: April 14, 1963

*Verne A. Morris*  
\_\_\_\_\_  
NOTARY PUBLIC