

15-185-01236-0000

STATE OF KANSAS  
STATE CORPORATION COMMISSION

WELL PLUGGING RECORD


Give All Information Completely  
Make Required Affidavit  
Mail or Deliver Report to:  
Conservation Division  
State Corporation Commission  
800 Biting Building  
Wichita, Kansas

OR

Strike out upper line  
when reporting plug-  
ging of formations.

~~FORMATION PLUGGING RECORD~~

NORTH

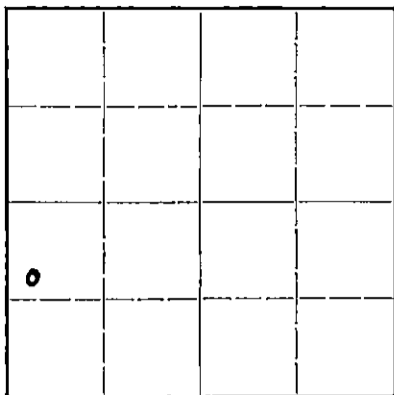

Locate well correctly on above  
Section Plat

Stafford County. Sec. 31 Twp. 24S Rge. (E) 13 (W)  
Location as "NE1/4NW1/4SW1/4" or footage from lines. 330 ft. fm Sth & West lines  
Lease Owner. Sinclair Prairie Oil Co  
Lease Name. Jacob Harter Well No. 1  
Office Address. Box 521, Tulsa, Okla.  
Character of Well (completed as Oil, Gas or Dry Hole). dry hole  
Date well completed. Jan. 4 1945  
Application for plugging filed. Jan 8 1945  
Application for plugging approved. Jan 10 1945  
Plugging commenced. Jan 4 1945  
Plugging completed. Jan 4 1945  
Reason for abandonment of well or producing formation.  
If a producing well is abandoned, date of last production. -- 19  
Was permission obtained from the Conservation Division or its agents before plugging was com-  
menced? yes

Name of Conservation Agent who supervised plugging of this well. H.W. Kerr  
Producing formation. Arbuckle Depth to top. 4410 Bottom. Total Depth of Well. 4440 Feet  
Show depth and thickness of all water, oil and gas formations.

OIL, GAS OR WATER RECORDS

CASING RECORD


Formation	Content	From	To	Size	Put In	Pulled Out
Arbuckle	dry	4410	4440	9-5/8 OD	330	0

Describe in detail the manner in which the well was plugged, indicating where the mud fluid was placed and the method or methods used in introducing it into the hold. If cement or other plugs were used, state the character of same and depth placed, from feet to feet for each plug set.

4440- 330' heavy mud  
330- 278' 15 sx cmt & wood plug  
278- 35 heavy mud  
35- to btm cellar 15 sx cmt.  
30 - 0 mud to surface

1-18-45

31 24 13W  
1 22

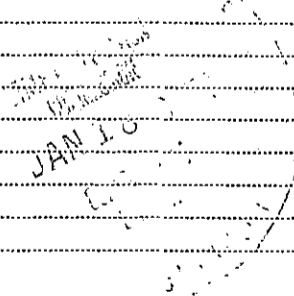

(If additional description is necessary, use BACK of this sheet)

Correspondence regarding this well should be addressed to Victor Chancellor  
Address. Box 774, Great Bend, Kans.

STATE OF Kansas, COUNTY OF Barton, ss.  
I, Victor Chancellor (employee of owner) or ~~owner~~ of the above-described well,  
being first duly sworn on oath, says: That I have knowledge of the facts, statements, and matters herein contained and the log of the above-described well as filed and that the same are true and correct. So help me God.

(Signature) Victor Chancellor

Box 774, Great Bend, Kas. (Address)

SUBSCRIBED AND SWORN to before me this 17th day of January, 1945  
J. H. MacFarlane  
Notary Public.

My commission expires 6-14-47

Well Log  
Sinclair Prairie Oil Co

Jacob Harter #1  
NW SW 31-24S-13W Stafford Co., Kas.  
330 ft fm Sth & West lines  
Elev. 1949'

Harbar Drilling Co-rotary  
Began drlg 11/20/1944  
Comp. drlg 1/4/1945  
TD 4440' dry hole  
9-5/8" set at 327' w/150sx

Drillers Log

Sand	150
Sand-Shale	330
Red Bed & Shale	855
Anhydrite	860
Lime	905
Shale & Shells	1044
Shale & Lime	1125
Shale & Shells	1305
Salt-Shells	1480
Lime & Shale	1810
Lime	2040
Lime & Shale	2195
Shale-Broken lime	2225
Lime & Shale	2305
Lime	2375
Lime & Shale	2515
Shale & Lime Shells	2605
Lime	2780
Lime & Shale	2880
Lime	2940
Lime Broken	2995
Lime-Shale	3135
Lime	3565
Lime & Shale	3675
Lime	3800
Lime-cherty	3835
Lime	3990
Lime-Shale	4090
Chert & Lime	4120
Chert	4204
Shale	4228
Shale & Chert	4296
Shale	4298
Chert	4317
Chert & Shale	4324
Chert	4332
Shale & Lime	4344
Cherty lime & Shale	4353
Shale	4356
Shale & Chert	4437
Schlumberger showed TD 4440'	dry hole
Geologists tops; Lansing	3695
Base-KC	3950
Conglomerate	4015
Miss.	4020
Viola	4190
Simpson	4364
Arbuckle	4412
TD	4437'

1-18-45

Plugged & abandoned 1/4/1945

31 24 (3W)  
1 22