
DISTRICT CONSERVATION AGENT'S REPORT

TO:

State Corporation Commission Conservation Division 800 Bitting Building Wichita, Kansas

I have today completed supervision of plugging of:

Well No. 2 Lease Judoy

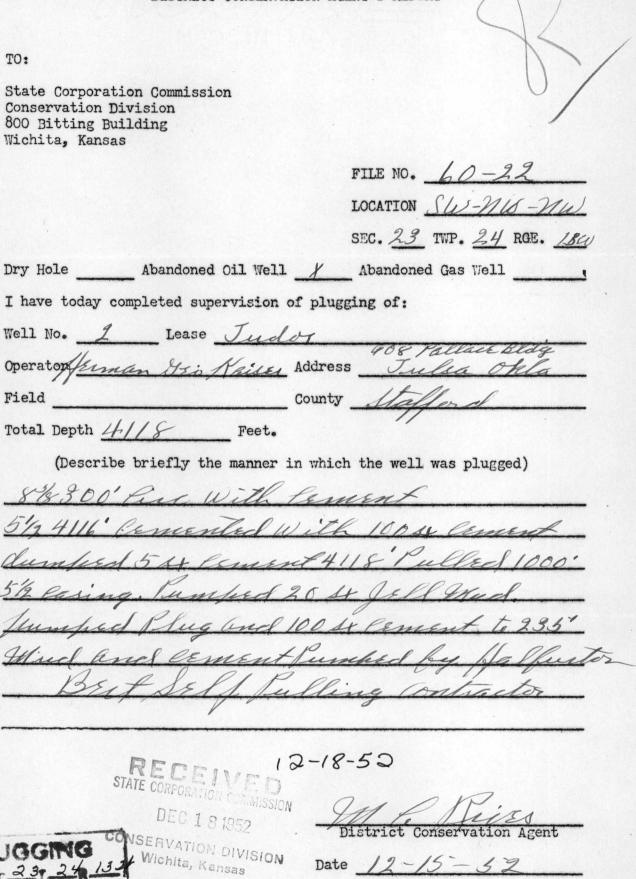

Operator/s	man Iso A	Address	s Julsa of	ela
Field		County	Stafford	
Total Depth	4118	Feet.	//	
(Desci	ribe briefly the	manner in which	h the well was plugge	d)
			-	
		12-18	2.50	
	STATE CORPORATION O	102-18	-50	
	DEC 1818	O'MISSION S	MA Ris	
LIACINA	CONSERVATION		District Conservation	Agent
-000mo	133 Wichita, Kans	IVISION Date	12-15-39	9
60 00 2				