

STATE OF KANSAS  
STATE CORPORATION COMMISSION


WELL PLUGGING RECORD

Give All Information Completely  
Make Required Affidavit  
Mail or Deliver Report to:  
Conservation Division  
State Corporation Commission  
212 North Market, Insurance Bldg.  
Wichita, Kansas

Stafford County, Sec. 26 Twp. 24S Rge. (E) 13 (W)

Location as "NE/CNW/SW" or footage from lines SW NW SE  
Lease Owner National Drilling Company, Inc.  
Lease Name Minks Well No. 1  
Office Address 535 Petroleum Building, Wichita, Kansas  
Character of Well (completed as Oil, Gas or Dry Hole) Dry Hole  
Date well completed October 7 1959  
Application for plugging filed October 7 1959  
Application for plugging approved October 8 1959  
Plugging commenced October 8 1959  
Plugging completed October 8 1959  
Reason for abandonment of well or producing formation Dry Hole

NORTH

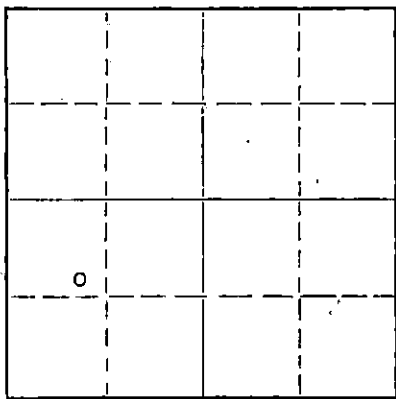

Locate well correctly on above  
Section Plat

If a producing well is abandoned, date of last production 19\_\_  
Was permission obtained from the Conservation Division or its agents before plugging was commenced? Yes

Name of Conservation Agent who supervised plugging of this well Frank Broadfoot  
Producing formation \_\_\_\_\_ Depth to top \_\_\_\_\_ Bottom \_\_\_\_\_ Total Depth of Well 4198 Feet  
Show depth and thickness of all water, oil and gas formations.


OIL, GAS OR WATER RECORDS

CASING RECORD

FORMATION	CONTENT	FROM	TO	SIZE	PUT IN	PULLED OUT
				8 5/8"	281	None

Describe in detail the manner in which the well was plugged, indicating where the mud fluid was placed and the method or methods used in introducing it into the hole. If cement or other plugs were used, state the character of same and depth placed, from \_\_\_\_\_ feet to \_\_\_\_\_ feet for each plug set.

Filled hole from total depth, 4198, to 306' with mud. Cement plug 306' to 240' with 20 sx cement. Mud from 240' to 73'. Cement plug 73' to 40' with 10 sx cement. Heavy rotary mud from 40' to cellar.

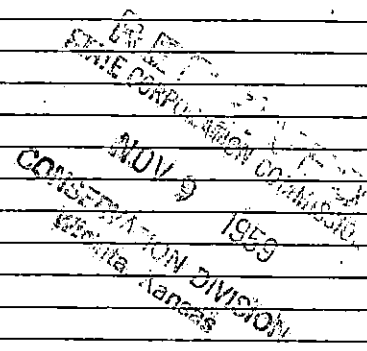

(If additional description is necessary, use BACK of this sheet)  
Name of Plugging Contractor National Drilling Company  
Address 533 Petroleum Building, Wichita, Kansas

STATE OF KANSAS, COUNTY OF SEDGWICK  
Howard A. Stoskopf (employee of owner) or (owner or operator) of the above-described well, being first duly sworn on oath, says: That I have knowledge of the facts, statements, and matters herein contained and the log of the above-described well as filed and that the same are true and correct. So help me God.

(Signature) Howard A. Stoskopf  
535 Petroleum Building, Wichita, Kansas (Address)

SUBSCRIBED AND SWORN TO before me this 13th day of October, 1959

Ruby Gourley Notary Public.  
RUBY GOURLEY  
My commission expires July 13, 1960

My commission expires \_\_\_\_\_

National #1 Minks  
 SW NW SE  
 Section 26-24S-13W  
 Stafford County, Kansas

Depth		Drilling Time Per Foot	Remarks
From	To		
3200	3210	2-2-1-2-2-2-2-1-3-2	
	3220	4-3-2-2-3-5-2-1-2-2	
	3230	2-2-3-4-5-5-5-2-5-4	
	3240	4-3-4-5-6-6-5-3-3-3	
	3250	4-4-3-2-2-2-3-2-3-3	
	3260	2-2-4-3-3-3-3-2-2-3	
	3270	3-2-2-4-3-3-2-2-1-2	
	3280	2-2-2-1-2-1-3-2-2-2	
	3290	2-2-2-2-4-3-2-4-4-4	
	3300	2-2-2-3-2-5-5-2-2-2	
3300	3310	2-3-3-3-3-2-4-3-3-2	
	3320	2-4-4-5-5-2-2-7-5-8	Trip 3320
	3330	3-3-3-3-3-2-3-4-3-2	
	3340	3-4-2-4-4-3-3-3-3-3	
	3350	3-3-3-3-3-3-3-3-3-3	
	3360	3-3-3-3-2-2-2-3-3-4	
	3370	3-4-3-3-3-3-3-3-3-3	
	3380	3-3-3-2-2-3-3-3-3-3	
	3390	3-3-3-3-3-3-3-2-3-2	
	3400	2-2-2-4-3-3-3-3-3-3	
3400	3410	3-4-4-4-4-4-4-2-4-4	
	3420	4-3-3-4-3-4-4-3-3-3	
	3430	4-5-4-4-4-3-3-2-1-2	
	3440	4-4-5-4-4-3-3-3-2-2	
	3450	3-3-3-3-2-2-2-3-3-3	
	3460	2-3-3-4-4-3-3-3-4-4	
	3470	5-3-3-3-3-2-3-3-2-2	
	3480	3-3-3-3-2-3-2-2-3-2	
	3490	3-2-2-2-2-2-3-2-2-3	
	3500	2-2-2-3-2-3-2-3-3-2	
3500	3510	2-1-1-2-2-2-2-2-2-2	
	3520	1-2-2-3-2-2-2-3-2-2	
	3530	3-2-2-3-3-2-2-2-3-2	
	3540	2-2-2-2-2-2-3-2-2-2	
	3550	2-2-2-1-2-2-2-2-2-2	

NOV 9 1959  
 CONSERVATION DIVISION  
 Wichita, Kansas

National #1 Minks  
 SW NW SE  
 Section 26-24S-13W  
 Stafford County, Kansas

Depth		Drilling Time Per Foot	Remarks
From	To		
3550	3560	1-2-3-2-2-1-2-2-2-1	
	3570	2-2-2-2-2-2-2-2-2-2	
	3580	2-3-2-3-3-3-3-2-3-2	
	3590	2-2-2-3-5-3-3-3-3-3	
	3600	2-3-3-3-3-3-3-3-3-3	
3600	3610	3-3-5-3-3-5-5-4-4-5	
	3620	5-5-5-6-6-5-5-3-3-3	
	3630	3-5-7-5-6-5-6-6-3-5	
	3640	3-5-3-3-3-6-6-4-4-7	Circ 3640
	3650	2-3-2-2-1-2-2-2-3-3	
	3660	4-2-4-3-4-5-4-4-5-5	
	3670	6-5-5-4-4-3-4-5-5-7	
	3680	6-8-5-7-7-6-4-3-3-5	
	3690	3-4-5-6-8-8-8-10-7-7	
	3700	6-6-6-5-3-3-2-3-2-4	SR 3697 & 3699
3700	3710	4-6-6-5-6-7-8-8-7-5	Circ 3705
	3720	6-5-6-6-6-7-7-6-6-7	
	3730	7-7-7-7-6-8-8-8-9-10	
	3740	10-6-4-5-7-9-3-2-2-2	SR 3737
	3750	3-3-4-8-8-9-9-8-8-10	Circ 3745
	3760	9-7-4-8-6-11-5-7-7-8	Circ 3760
	3770	4-3-5-4-3-4-3-4-3-2	
	3780	3-3-3-3-4-4-4-3-3-2	
	3790	2-1-1-1-3-1-2-2-3-3	
	3800	3-4-4-4-4-3-4-4-5-4	
3800	3810	4-2-2-2-3-3-2-4-3-3	
	3820	3-2-3-3-4-3-4-5-4-5	
	3830	5-5-5-5-5-5-5-5-5-7	
	3840	6-6-7-7-7-6-4-5-4-3	
	3850	3-4-4-4-4-4-6-6-5-6	
	3860	7-7-7-7-7-6-4-4-2-3	Circ 3852
	3870	7-5-4-7-5-4-6-7-5-7	SR 3867
	3880	7-7-5-6-5-5-5-4-4-3	
	3890	3-3-4-4-5-6-6-5-5-4	
	3900	5-4-5-7-9-9-8-10-10-10	

RECEIVED  
 NOV 9 1959  

National #1 Minks  
 SW NW SE  
 Section 26-24S-13W  
 Stafford County, Kansas

 Wichita, Kansas

Depth		Drilling Time Per Foot	Remarks
From	To		
3900	3910	6-6-5-6-5-7-10-6-6-8	
	3920	7-6-6-3-10-8-7-9-10-12	
	3930	9-9-9-9-13-7-4-6-6-5	Trip 3926
	3940	3-3-4-5-6-5-4-4-4-4	
	3950	4-6-5-5-4-6-2-4-3-6	
	3960	3-4-4-5-5-5-5-5-5-6	
	3970	5-5-5-5-4-3-5-6-5-5	
	3980	5-6-6-6-5-5-6-5-6-5	
	3990	5-4-3-4-8-7-8-6-7-8	SR 3983 & 3984
	4000	10-7-8-6-6-8-5-7-7-7	SR 3992
4000	4010	7-6-7-5-2-2-5-2-1-4	SR 4004, 05, 06, & 07
	4020	7-7-11-7-13-5-5-5-8-2	Circ 4014 & 4016
	4030	2-4-6-5-8-8-5-10-10-10	SR 4021, 22, 24, 27, & 29
	4040	10-10-8-9-9-8-5-5-6-4	SR 4032 & 4038
	4050	7-8-6-8-8-9-9-6-8-8	BR 4048
	4060	9-6-6-6-9-9-7-7-10-9	
	4070	9-8-9-6-8-10-10-10-7-9	
	4080	13-11-9-9-9-10-13-13-12-12	
	4090	13-14-11-11-12-8-7-7-10-9	Trip 4085
	4100	7-9-8-7-5-6-7-6-9-12	
4100	4110	10-12-10-12-11-9-12-10-9-10	
	4120	11-11-10-9-10-12-7-9-10-6	
	4130	6-6-6-7-7-7-5-5-4-4	
	4140	4-4-4-6-3-5-5-5-6-6	Circ 4140
	4150	5-5-4-3-3-4-10-4-7-8	
	4160	7-5-5-6-5-6-5-5-7-4	
	4170	6-6-6-6-6-5-6-6-6-5	
	4180	4-5-5-4-5-5-7-7-6-6	Circ 4175
	4190	6-6-6-5-5-5-5-3-6-6	SR 4181, 86, & 87; Circ 4182
	4198	5-7-7-8-10-10-12-11	