

15-185-19233-0001

WELL PLUGGING RECORD


FORMATION PLUGGING RECORD

STATE OF KANSAS
 STATE CORPORATION COMMISSION

Give All Information Completely
 Make Required Affidavit
 Mail or Deliver Report to:
 Conservation Division
 State Corporation Commission
 800 Bitting Building
 Wichita, Kansas

Strike out upper line
 when reporting plug-
 ging of formations.

Stafford County. Sec. 23 Twp. 24 Rge. (E) 13 (W)
 Location as "NE $\frac{1}{4}$ NW $\frac{1}{4}$ SW $\frac{1}{4}$ " or footage from lines CWL SE/4
 Lease Owner Lario Oil & Gas Company
 Lease Name J. R. Morgan Well No. 3
 Office Address 301 South Market, Wichita, Kansas
 Character of Well (completed as Oil, Gas or Dry Hole) Oil
 Date well completed March 15, 1937
 Application for plugging filed December 15, 1949
 Application for plugging approved December 15, 1949
 Plugging commenced December 15, 1949
 Plugging completed December 30, 1949
 Reason for abandonment of well or producing formation Depleted well

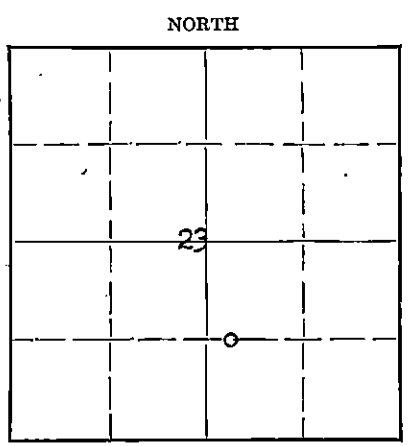

If a producing well is abandoned, date of last production June 1949
 Was permission obtained from the Conservation Division or its agents before plugging was commenced? Yes

Name of Conservation Agent who supervised plugging of this well Charles Stough
 Producing formation Arbuckle Depth to top 4065 Bottom 4081 Total Depth of Well 4081 Feet
 Show depth and thickness of all water, oil and gas formations.

OIL, GAS OR WATER RECORDS

CASING RECORD

Formation	Content	From	To	Size	Put In	Pulled Out
				12 1/2"	255	None
				6 5/8"	4119	2717

Describe in detail the manner in which the well was plugged, indicating where the mud fluid was placed and the method or methods used in introducing it into the hole. If cement or other plugs were used, state the character of same and depth placed, from _____ feet to _____ feet for each plug set.

Run 6 sacks of cement at 3800', mudded hole and set bridge at 255' and run 25 sacks of cement, mudded hole and run 10 sacks of cement to base of cellar for cap.

1-19-50

JAN 19 1950

(If additional description is necessary, use BACK of this sheet)

Correspondence regarding this well should be addressed to Lario Oil & Gas Company
 Address 301 South Market
 Wichita, Kansas

STATE OF KANSAS, COUNTY OF SEDGWICK, ss.
 Leo Ross (employee of owner) or (owner or operator) of the above-described well,

being first duly sworn on oath, says: That I have knowledge of the facts, statements, and matters herein contained and the log of the above-described well as filed and that the same are true and correct. So help me God.

(Signature) *Leo Ross*

301 So. Market, Wichita, Kansas (Address)

SUBSCRIBED AND SWORN to before me this 18th day of January, 19 50

My commission expires February 2, 1952

Dois Smalley
 Notary Public.

22-2625 2-48-15M

PLUGGING
 FILE SEC-23T 24R 130
 BOOK PAGE 130 LINE 31

LARIO OIL & GAS COMPANY
Morgan #3

C WL SE/4 Sec. 23-24S-13W
Stafford County, Kansas

Total Depth - 4131'
Commenced - March 22, 1937
Completed - May 7, 1937
Contractor - Broadwater Drilling Co.

CASING

EST EI. 1910 G.L.

12 1/2" 255'
7" 4119'

FIGURES INDICATE BOTTOM OF FORMATIONS

Surface	255	Halliburton test	4131
Shale red	375	17.8 oil) 30 Min	
Shale and shells	607	15.5 wtr)	
Shale red	665	2000' oil & 1500' water	
Shale and shells	1296	Swabbed 34 bbl. oil &	
Salt, lime and shells	1410	30 bbl. water per hr.	
Shale and shells	1626	Plugged back	4125'
Lime	1639	Swabbed 30 bbl. oil & 10 bbl.	
Shale and shells	1659	water per hr. for 10 hrs.	
Lime broken	1854	Plugged back	4124'
Shale and shells	1949	Potential 795 & 20% water	
Shale	1991		
Lime	2054	Top Simpson	4070'
Shale and shells	2089	Top Siliceous	4119'
Lime	2104		
Shale and lime	2308		
Shale	2378		
Lime and shale	2406		
Shale	2420		
Lime	2500		
Shale	2539		
Shale and shells	2951		
Shale and lime	2648		
Shale	2700		
Shale and shells	2847		
Shale and lime	2990		
Shale and shells	3048		
Shale and lime	3290		
Shale and lime	3449		
Lime shells and shale	3537		
Lime and shale	3708		
Lime	3737		
Lime and shale	3940		
Chat	3943		
Lime and chat	3972		
	3972-70		
Chat and lime	4056		
Lime	4072		
Shale	4105		
cored - 4105-4131			

4131 T.D.

RECORDED

DEC 21 1949 12-21-49
STATE OF KANSAS
COMMISSIONER OF OIL AND GAS

PLUGGING
FILE SEC-23 T-24 R-13W
BOOK PAGE 120 LINE 38