

15-185-19232-0000

STATE OF KANSAS
STATE CORPORATION COMMISSION

WELL PLUGGING RECORD


FORMATION PLUGGING RECORD

Give All Information Completely
Make Required Affidavit
Mail or Deliver Report to:
Conservation Division
State Corporation Commission
800 Bitting Building
Wichita, Kansas

OR

Strike out upper line
when reporting plug-
ging of formations.

Stafford County, Sec. 23 Twp. 24 Rge. 13 (E) (W)
Location as "NE 1/4 NW 1/4 SW 1/4" or footage from lines CNL SE 1/4
Lease Owner Lario Oil & Gas Company
Lease Name J. R. Morgan Well No. 2
Office Address 301 South Market, Wichita, Kansas
Character of Well (completed as Oil, Gas or Dry Hole) Oil
Date well completed March 14, 1937
Application for plugging filed April 16, 1950
Application for plugging approved May 8, 1950
Plugging commenced April 17, 1950
Plugging completed May 4, 1950
Reason for abandonment of well or producing formation Oil Exhausted

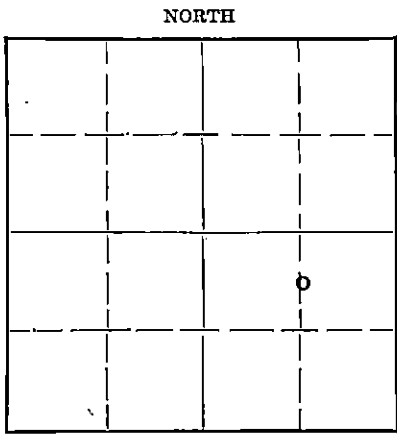

Locate well correctly on above
Section Plat

If a producing well is abandoned, date of last production February 1950
Was permission obtained from the Conservation Division or its agents before plugging was com-
menced? Yes

Name of Conservation Agent who supervised plugging of this well C. D. Stough
Producing formation Arbuckle & Lansing Depth to top Bottom Total Depth of Well 4081 Feet
Show depth and thickness of all water, oil and gas formations.

OIL, GAS OR WATER RECORDS

CASING RECORD

Formation	Content	From	To	Size	Put In	Pulled Out
				12 1/2"	245'	None
				8 1/4"	4068'	2595'

Describe in detail the manner in which the well was plugged, indicating where the mud fluid was placed and the method or methods used in introducing it into the hole. If cement or other plugs were used, state the character of same and depth placed, from feet to feet for each plug set.

Set 8 5/8" HOWCO limit plug at 3789', dumped 11 sacks of cement, top of plug at 3743 1/2', tested Lansing formation, run 8 sacks cement at 3620', shot casing at 2573' mudded hole to 245 feet, set bridge, run 25 sacks of cement mudded hole to top, run 10 sacks of cement for cap in base of cellar

RECORDED

Cons. Div. 11

MAY 13 1951

5-13-50

STATE CORPORATION
COMMISSION
KANSAS

(If additional description is necessary, use BACK of this sheet)

Correspondence regarding this well should be addressed to Lario Oil & Gas Company
Address 301 South Market
Wichita, Kansas

STATE OF Kansas COUNTY OF Stafford, ss.
Leo Ross (employee of owner) or (owner or operator) of the above-described well,
being first duly sworn on oath, says: That I have knowledge of the facts, statements, and matters herein contained and the log of the above-described well as filed and that the same are true and correct. So help me God.

(Signature) *Leo Ross*


(Address)

SUBSCRIBED AND SWORN to before me this 12th day of May, 1950

My commission expires February 2, 1952

February 2, 1952

22-2026

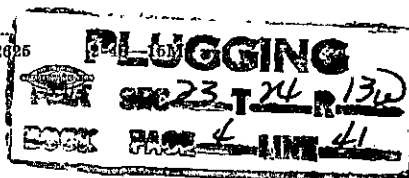

Doris Smalley
Notary Public.

LARIO OIL & GAS COMPANY
 ATLANTIC TERMINAL COMPANY
 MARINE OIL & REFG. COMPANY

15-185-19232-0000
 Sec. 23, Twp. 24S, Rrc. 13W
 Center North Line 1/2
 Stafford County, Kansas

No. 2 J. R. MORCAN

Total Depth 4081'.
 Commenced February 9, 1937
 Completed March 14, 1937
 Contractor: Broadwater Drilling Co.

Ed 1907

CASING

12 1/2" 245' 8 1/2" 4066'

FIGURES INDICATE BOTTOM OF FORMATION

sand & red shale	245	sandy lime	3469
red shale	655	shale & lime	3591
shale	875	lime	3622
shale & shells	1173	broken lime & shale	3654
salt	1493	lime	3664
shale & shells	1631	lime & shale	3830
lime shells & shale	1680	shale	3845
lime	1690	lime	3850
broken lime	1728	shale	3868
lime & shale	1926	lime & shale	3877
lime	2013	lime	3905
shale	2040	chat & lime	3961
broken lime	2056	shale & lime	3975
sandy lime	2067	lime & shale	4065
shale	2090	dolomite	4066
lime & shale	2104	Standardized	
lime	2116	dolomite	4081
shale & shells	2177	Total Depth.	
lime & shale	2254	Cored 4053-56'.	
shale	2270	Filled up 3500' oil in 8 hours.	
lime	2280	Swabbed 55 bbl. oil per hour.	
shale	2295	Potential: 1444 Bbl. oil.	
lime & shale	2385		
shale & shells	2421	Top Kansas City 3828'.	
shale	2430	Top Viola 3895'.	
lime	2445	Top Simpson 4010'.	
shale	2478	Top Arbuckle 4065'.	
shale & shells	2638		
shale	2716		
sandy lime	2750		
lime	2783		
shale	2965		
lime	2985		
shale	2992		
shale & shells	3060		
lime & shale	3123		
shale	3164		
lime	3176		
shale	3215		
lime	3277		
lime & shale	3328		
lime	3374		
broken lime	3401		
shale	3434		
sand	3444		
shale & shells	3463		

I, G. D. Putnam, being first duly sworn on oath, state that I have knowledge of the facts and matter herein presented and that the same are true and correct.

G. D. Putnam

Subscribed and sworn before me this 17th day of March, 1937.

E. O. Black
 Notary Public

My Commission Expires:
 April 28, 1937.

RECORDED
 MAY 25 1950 5-25-50
 STAFFORD COUNTY RECORDS

INDEXED
 FILED
 APR 23 1937
 BOOK PAGE 4 41