

STATE OF KANSAS  
STATE CORPORATION COMMISSION


Give All Information Completely  
Make Required Affidavit  
Mail or Deliver Report to:  
Conservation Division  
State Corporation Commission  
800 Bitting Building  
Wichita, Kansas

15-185-12362-0000  
WELL PLUGGING RECORD

OR  
FORMATION PLUGGING RECORD

Strike out upper line  
when reporting plug-  
ging off formations.

NORTH

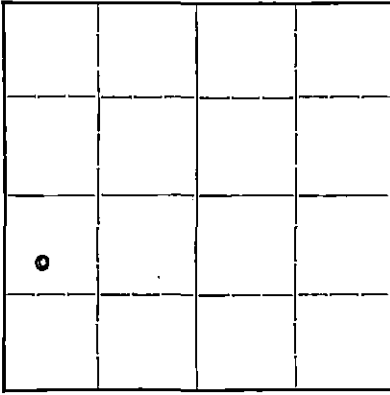

Locate well correctly on above  
Section Plat

Stafford County, Sec. 25 Twp. 24 Rge. 13 (W)  
Location as "NE $\frac{1}{4}$ NW $\frac{1}{4}$ SW $\frac{1}{4}$ " or footage from lines 990' South & 660' East of W $\frac{1}{2}$  Cor.  
Lease Owner: Cities Service Oil Co.  
Lease Name: Benton Well No. 5  
Office Address: Bartlesville, Okla.  
Character of Well (completed as Oil, Gas or Dry Hole): Dry Hole  
Date, well completed: August 2, 1941  
Application for plugging filed: August 2, 1941  
Application for plugging approved: Aug. 2, 1941  
Plugging Commenced: Aug. 3, 1941  
Plugging Completed: Aug. 3, 1941  
Reason for abandonment of well or producing formation: Dry  
If a producing well is abandoned, date of last production: 19  
Was permission obtained from the Conservation Division or its agents before plugging was com-  
menced? Yes

Name of Conservation Agent who supervised plugging of this well: C. T. Alexander  
Producing formation: Depth to top: Bottom: Total Depth of Well: 4160 Feet  
Show depth and thickness of all water, oil and gas formations.

OIL, GAS OR WATER RECORDS

CASING RECORD

Formation	Content	From	To	Size	Put In	Pulled Out
				10 3/4"	340' Cemented with 200 sacks	None

Describe in detail the manner in which the well was plugged, indicating where the mud fluid was placed and the method or methods used in introducing it into the hole. If cement or other plugs were used, state the character of same and depth placed, from \_\_\_\_\_ feet to \_\_\_\_\_ feet for each plug set.

Filled with rotary mud from 4160 to 345'; 8' wood plug to 343'; cement from 343' to 325'; heavy mud from 325' to 30'; wood plug to 28'; 5 sacks cement from 28' to 20'; soil from 20' to surface and steel cap welded on top.

*pd*  
*8/28/41*  
*23 24 13W*  
*1 23*

(If additional description is necessary, use BACK of this sheet)

Correspondence regarding this well should be addressed to: R.C. Hauber, Cities Service Oil Company  
Address: Great Bend, Kansas

STATE OF Kansas COUNTY OF Barton, ss.  
A. P. Bates (employee of owner) or (owner or operator) of the above-described well,  
being first duly sworn on oath, says: That I have knowledge of the facts, statements, and matters herein contained and the log of the above-described well as filed and that the same are true and correct. So help me God.

(Signature) *A. P. Bates*

Chase, Kansas (Address)

SUBSCRIBED AND SWORN to before me this 8 day of Aug 1941

*9-6-41*  
*Notary Public*

My Commission Expires Sept. 26, 1942

My commission expires



WELL RECORD

Company Cities Service Oil Co. Well No. 5 Farm Benton  
 Location 990' South & 660' East of W/4 Cor. Sec. 23 T. 24 R. 13-W  
 Elevation 1929 County Stafford State Kansas  
 Drlg. Comm. July 17, 1941 Contractor Hisson Drilling Company  
 Drlg. Comp. August 2, 1941 Acid None  
 T. D. 4160 Initial Prod. Dry - P. & A.

CASING RECORD:

10" @ 340' con. 200 sx Red Ring  
& 2 sx C. C.

FORMATION RECORD:

sand 0-200  
 red bed 305  
 red bed & lime shells 340  
 shale & red bed 913  
 red rock & shells 1290  
 salt 1340  
 salt & shale 1440  
 shale & lime shells 1625  
 lime 1655  
 lime & shale 1805  
 shale & shells 1900  
 lime shells & shale 1990  
 lime & shale 2240  
 shale & shells 2360  
 lime 2431  
 shale 2570  
 shale & shells 2700  
 lime & shale 2806  
 shale & lime 2870  
 lime shells & shale 2985  
 broken lime 3089  
 lime & shale 3430  
 lime 3513  
 shale 3548  
 lime 3912  
 shale 3945  
 lime & chert 3991  
 chert 4049  
 lime 4081  
 shale & sand 4108  
 shale 4125  
 lime & chert 4137  
 lime 4160 T. D.

Top Arbuckle 4121  
 Penetration 39  
 Total Depth 4160

Fair porosity, no saturation 4137-41.  
 Fair porosity, no saturation 4155-59.

SYFO: 750' OK  
 1000' OK  
 1250' OK  
 1500' OK  
 1750' OK  
 2000' OK  
 2250' OK  
 2500' OK  
 2750' OK  
 3000' OK  
 3500' OK

9-6-41



23 24 - 13W  
 1 23