


Give All Information Completely
Make Required Affidavit
Mail or Deliver Report to:
Conservation Division
State Corporation Commission
211 No. Broadway
Wichita, Kansas

WELL PLUGGING RECORD

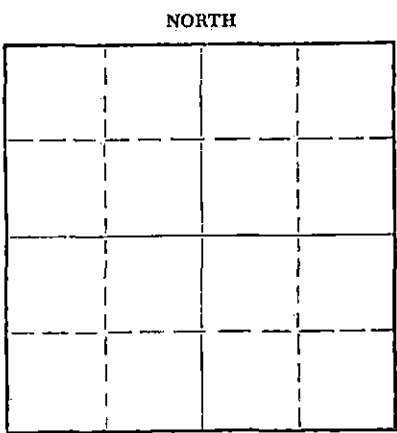

Locate well correctly on above
Section Plat

Stafford County. Sec. 24 Twp. 24 Rge. 3W (E) (W)
Location as "NE/CNW/SW" or footage from lines E/2 E/2 NW
Lease Owner Hudson Petroleum Company
Lease Name McCune Well No. 1
Office Address 1112 SW Blvd. Kansas City, Missouri
Character of Well (completed as Oil, Gas or Dry Hole) depleted oil
Date well completed April 28, 19 59
Application for plugging filed September 14, 19 60
Application for plugging approved September 21, 19 60
Plugging commenced September 3, 19 60
Plugging completed September 3, 19 60
Reason for abandonment of well or producing formation

If a producing well is abandoned, date of last production 19
Was permission obtained from the Conservation Division or its agents before plugging was commenced? yes

Name of Conservation Agent who supervised plugging of this well Frank Broadfoot
Producing formation Depth to top Bottom Total Depth of Well 4123' Feet
Show depth and thickness of all water, oil and gas formations.

OIL, GAS OR WATER RECORDS

CASING RECORD

FORMATION	CONTENT	FROM	TO	SIZE	PUT IN	PULLED OUT

Describe in detail the manner in which the well was plugged, indicating where the mud fluid was placed and the method or methods used in introducing it into the hole. If cement or other plugs were used, state the character of same and depth placed, from feet to feet for each plug set.

8 5/8" 300 Circ- 5 1/2 - 4123' - Top Perf 3568'
Sanded to 3850' w/5 sacks cement thru bailer- Pulled 3230' 5 1/2 - pumped
38 Bbls Rotary Mud thru 5 1/2 G 700' - Rock bridge @ 250' w/20 sacks cement
Mud to 40' - Rock bridge w/10 sacks cement cap to base of cellar.

2-5-1965

Conservation Division
Wichita, Kansas
FEB 5 1965

(If additional description is necessary, use BACK of this sheet)
Name of Plugging Contractor Southwest Casing Pulling Company # 299
Address Great Bend, Kansas

STATE OF Kansas, COUNTY OF Barton, ss.
Southwest Casing Pulling Co., Inc. (employee of owner) or (owner or operator) of the above-described well, being first duly sworn on oath, says: That I have knowledge of the facts, statements, and matters herein contained and the log of the above-described well as filed and that the same are true and correct. So help me God.

(Signature) Ernest D. Miller Pres.
Great Bend, Kansas
(Address)

SUBSCRIBED AND SWORN to before me this 2 day of February, 19 65

My commission expires Feb. 28, 1968

Wanda C. Spencer
Notary Public.

15-185-00297-0000


WELL LOG BUREAU—KANSAS GEOLOGICAL SOCIETY
508 East Murdock, Wichita, Kansas

Company. HUDSON PETROLEUM CO.
Farm. McCune No. 1

SEC. 24 T. 24 R. 13W
C E/2 E/2 NW

Total Depth. 4125'
Comm. 4-14-59 Comp. 4-28-59
Shot or Treated.
Contractor. Chief Drlg.
Issued. 8-1-59

County Stafford
KANSAS

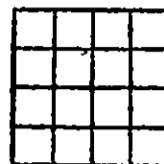

Elevation. 1904'

Production. 43 BOPD

Figures indicate Bottom of Formations.

sand & clay	40
shale & sand	250
shale	280
shale & red bed	345
sand & red bed	445
sand	490
shale & shells	735
Anhydrite	760
sand, shale & shell	1140
shale & shells	1680
shale & lime	2105
lime	2255
lime & shale	2290
shale w/lime	2465
shale & lime	3544
lime	3795
shale & lime	3919
chert & lime	4053
shale & sand	4108
dolomite	4125
Total Depth	

TOPS:

Heebner	3367
Toronto	3386
Brown Lime	3514
Lansing-Kansas City	3544
Base Kansas City	3795
Viola	3919
Simpson	4053
Arbuckle	4108

Perf. 3935-38 w/18 shots (Viola)
no shows oil or water
Perf. 4084-86 w/12 shots (Simpson)
no shows oil or water.
Perf. 3568-74 w/24 shots (Lansing)
Swab 5 bbl. oil per hour/6 hr.
Acidized w/500 gal.
Swab 10 bbl. oil per hr/7 hr.

RECEIVED
STATE CORPORATION COMMISSION
JUL 10 1954
CONSERVATION DIVISION
Wichita, Kansas