

Give All Information Completely
Make Required Affidavit
Mail or Deliver Report to:
Conservation Division
State Corporation Commission
212 No. Market
Wichita, Kansas

WELL PLUGGING RECORD

~~Stafford~~ **Stafford** County. Sec. 35 Twp. 24S Rge. (E) 13 (W)

Location as "NE/CNW4SW4" or footage from lines NE SE SE
Lease Owner REX & MORRIS DRILLING CO., MC CLURE OIL CO., & CRA, Inc.

Lease Name CLOWERS Well No. 1

Office Address P. O. BOX 334, EL DORADO, KANSAS 67042

Character of Well (completed as Oil, Gas or Dry Hole) DRY HOLE

Date well completed 23 DECEMBER 1965

Application for plugging filed 23 DECEMBER 1965

Application for plugging approved 23 DECEMBER 1965

Plugging commenced 23 DECEMBER 1965

Plugging completed 23 DECEMBER 1965

Reason for abandonment of well or producing formation DRY HOLE


If a producing well is abandoned, date of last production NONE 19

Was permission obtained from the Conservation Division or its agents before plugging was commenced? YES

Name of Conservation Agent who supervised plugging of this well ARCHIE ELVING

Producing formation NONE Depth to top Bottom Total Depth of Well 4200'RB Feet

Show depth and thickness of all water, oil and gas formations.

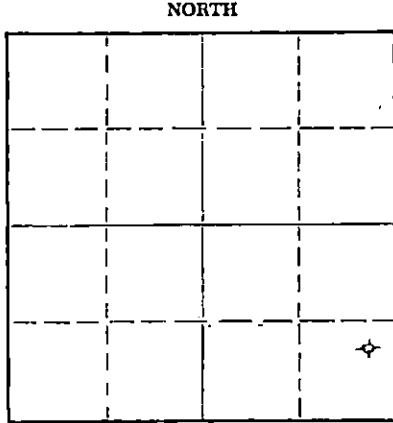

Locate well correctly on above Section Plat

OIL, GAS OR WATER RECORDS

CASING RECORD

FORMATION	CONTENT	FROM	TO	SIZE	PUT IN	PULLED OUT
SURFACE HOLE	WATER	SURFACE	264'RB	8 5/8"OD	258.75'	LEFT IN
(SEE ATTACHED LOG)						

Describe in detail the manner in which the well was plugged, indicating where the mud fluid was placed and the method or methods used in introducing it into the hole. If cement or other plugs were used, state the character of same and depth placed, from feet to feet for each plug set.

FILLED HOLE WITH HEAVY DRILLING MOD TO 240', SET HULLS & PLUG AND CEMENTED WITH 25 SACKS CEMENT. FILLED HOLE WITH DRILLING MOD TO 40', SET HULLS AND PLUG AND CEMENTED WITH 10 SACKS CEMENT. CAPPED RAT HOLE WITH 2 SACKS CEMENT.

RECEIVED
JUN 24 1966
CONSERVATION DIVISION
WICHITA, KANSAS

(If additional description is necessary, use BACK of this sheet)

Name of Plugging Contractor REX & MORRIS DRILLING COMPANY

Address P. O. BOX 334, EL DORADO, KANSAS 67042

STATE OF KANSAS COUNTY OF BUTLER, ss.
A. H. FISHER (employee of owner) or (owner or operator) of the above-described well, being first duly sworn on oath, says: That I have knowledge of the facts, statements, and matters herein contained and the log of the above-described well as filed and that the same are true and correct. So help me God.

(Signature) A. H. Fisher

P. O. BOX 334, EL DORADO, KANSAS 67042
(Address)

SUBSCRIBED AND SWORN to before me this 21ST day of JANUARY, 19 66

My commission expires 5 MAY 1969

Hazel N. Dilts
HAZEL N. DILTS Notary Public.

STATE OF KANSAS
COMMISSION

JAN 24 1966

CLOWERS #1

REX & MORRIS, ETAL

CONSERVATION DIVISION
WICHITA, KANSAS

Elevation 1917 RB
1912 GL

Total Depth: 4200' RB
Contractor: Rex & Morris
Commenced: 12-12-65
Completed: 12-23-65
Initial Prod.: D & A

Location: NE SE SE
Section 35-24S-13W
Stafford County, Kansas

Casing Record:
8 5/8" OD Set at 264' RB
w/220 sacks

FORMATION	DEPTH
Surface Hole	264'
Shale	756'
Anhydrite	772'
Shale	1200'
Lime & Shale	3035'
Lime	3385'
Lime & Shale	3435'
Shale	3580'
Lime-Lans. KC	3858'
Lime & Shale	3936'
Shale - Kinderhook	3974'
Lime - Viola	4110'
Sand - Simpson	4172'
Lime - Arbuckle R.T.D.	4200'

I hereby certify the foregoing statements are true and correct to the best of my knowledge and belief.

Rex & Morris Drilling Company

By

A. H. Fisher
A. H. Fisher

STATE OF KANSAS
COUNTY OF BUTLER, SS.

Subscribed and sworn to before me, a Notary Public, this 21st day of January, 1966.

Hazel N. Dilts
Hazel N. Dilts, Notary Public

My commission expires: May 5, 1969.