


STATE OF KANSAS
STATE CORPORATION COMMISSION

WELL PLUGGING RECORD

Give All Information Completely
Make Required Affidavit
Mail or Deliver Report to
Conservation Division
State Corporation Comm.
245 North Water
Wichita, KS 67202

Stafford County. Sec. 35 Twp. 24S Rge. 13W E/W
Location as "NE/CNW $\frac{1}{4}$ SW $\frac{1}{4}$ " or footage from lines
890' FSL 2310' FWL
Lease Owner Robinson Oil Co.
Lease Name Fisher A Well No. 1
Office Address 300 West Douglas, Wichita, Kansas 67202
Character of Well (Completed as Oil, Gas or Dry Hole) Dry Hole

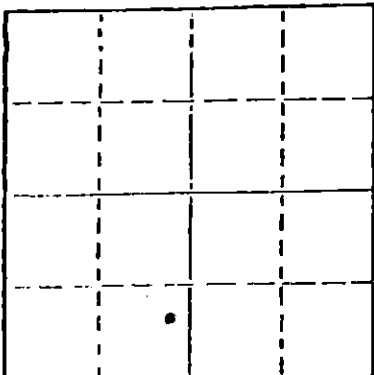

Locate well correctly on above
Section Plot

Date Well completed 1-8 1984
Application for plugging filed 1-8 1984
Application for plugging approved 1-8 1984
Plugging commenced 1-8 1984
Plugging completed 1-8 1984
Reason for abandonment of well or producing formation Dry Hole

If a producing well is abandoned, date of last production 19

Was permission obtained from the Conservation Division or its agents before plugging was commenced? Yes

Name of Conservation Agent who supervised plugging of this well Steve Durrant
Producing formation _____ Depth to top _____ Bottom _____ Total Depth of Well _____
Show depth and thickness of all water, oil and gas formations.

OIL, GAS OR WATER RECORDS

CASING RECORD

FORMATION	CONTENT	FROM	TO	SIZE	PUT IN	PULLED OUT
Surface Pipe	24#	0	334	8 5/8"	334	None

Describe in detail the manner in which the well was plugged, indicating where the mud fluid was placed and the method or methods used in introducing it into the hold. If cement or other plugs were used, state the character of same and depth placed, from _____ feet to _____ feet for each plug set.

Filled hole with heavy mud.

#1 plug set @ 780' with 50 sacks cement..

#2 plug set @ 360' with 50 sacks cement.

#3 plug set @ 40' with 10 sacks cement.

#4 plug set in rate with 10 sacks cement.

(If additional description is necessary, use BACK of this sheet)

Name of Plugging Contractor Sweetman Drilling, Inc.


STATE OF Kansas COUNTY OF Sedgewick, ss.
Dale M. Robinson (~~employee of owner~~) ~~or~~ (~~owner~~ or operator)
of the above-described well, being first duly sworn on oath, says: That I have knowledge of the facts, statements, and matters herein contained and the log of the above-described well as filed and that the same are true and correct. So help me God.

(Signature) Dale M. Robinson
737 R. H. Garvey Bldg., Wichita, KS
(Address)

SUBSCRIBED AND SWORN TO before me this 28th day of March, 1984

Barbara E. Caughron
Notary Public.

My commission expires

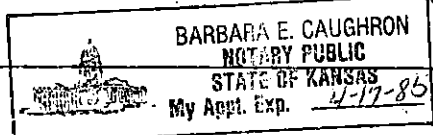

RECEIVED
STATE CORPORATION COMMISSION
MAR 30 1984
CONSERVATION DIVISION
Wichita, Kansas