


15-185-00084-0000

STATE OF KANSAS
STATE CORPORATION COMMISSION

Give All Information Completely
Make Required Affidavit
Mail or Deliver Report to:
Conservation Division
State Corporation Commission
800 Bittling Building
Wichita, Kansas

WELL PLUGGING RECORD

NORTH

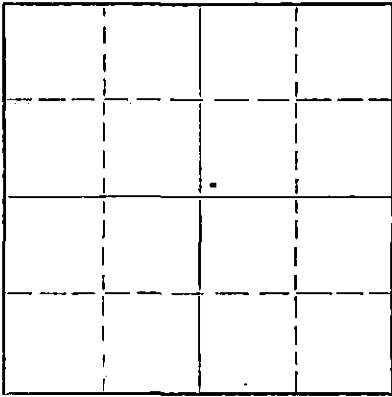

Locate well correctly on above
Section Plot

Stafford County. Sec. 35 Twp. 24 Rge. 13 (E) W (W)
Location as "NE/CNW/SW" or footage from lines SW SW NE
Lease Owner John Lindas Oil, Inc.
Lease Name Asher Well No. 1
Office Address 1316 Union National Bank Building, Wichita, Kansas
Character of Well (completed as Oil, Gas or Dry Hole) Dry Hole
Date well completed 12-17-1952
Application for plugging filed 12-17-1952
Application for plugging approved 12-17-1952
Plugging commenced 12-18-1952
Plugging completed 12-18-1952
Reason for abandonment of well or producing formation Dry hole

If a producing well is abandoned, date of last production 19
Was permission obtained from the Conservation Division or its agents before plugging was commenced? Yes.

Name of Conservation Agent who supervised plugging of this well M. A. Rives
Producing formation Depth to top Bottom Total Depth of Well 4210' Feet
Show depth and thickness of all water, oil and gas formations.

OIL, GAS OR WATER RECORDS

CASING RECORD

FORMATION	CONTENT	FROM	TO	SIZE	PUT IN	PULLED OUT
				8-5/8"	360'	Cemented w/ 225 sacks

Describe in detail the manner in which the well was plugged, indicating where the mud fluid was placed and the method or methods used in introducing it into the hole. If cement or other plugs were used, state the character of same and depth placed, from feet to feet for each plug set.

Filled with mud from 4210' to 300', set plug @ 300' put in 20 sacks cement, filled with mud from 300' to 30', set plug @ 30', filled with 10 sacks of cement.

12-20-52
CO.

(If additional description is necessary, use BACK of this sheet)
Name of Plugging Contractor John Lindas Oil, Inc.
Address 1316 Union National Bank Building, Wichita, Kansas


STATE OF Kansas, COUNTY OF Sedgwick, ss.
I, Fred Moore (employee of owner) or (owner or operator) of the above-described well, being first duly sworn on oath, says: That I have knowledge of the facts, statements, and matters herein contained and the log of the above-described well as filed and that the same are true and correct. So help me God.

(Signature) Fred Moore
1316 Union National Bank Bldg; Wichita, Ks.
(Address)

SUBSCRIBED AND SWORN TO before me this 19th day of December, 1952

Edward W. Ziemer
Notary Public.

My commission expires October 8, 1955

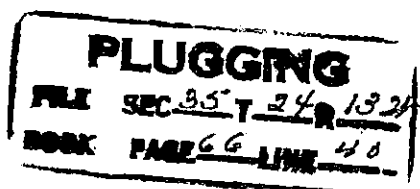

DRILLING LOG

Lease Operator: John Lindas Oil, Inc.
1316 Union National Bank Bldg.
Wichita, 2, Kansas

County: Stafford
Location: SW SW NE
Section: 35-24S-13W
Elevation: 1917' RB

Well: Asher No. 1


Rotary Total Depth:
Commenced:
Completed:
Casing:

4210'
November 29, 1952
December 18, 1952
8-5/8" @ 360' with
225 sacks of cement
and 2 sacks of calcium
chloride.

Contractor: John Lindas Oil, Inc.
1316 Union National Bank Building
Wichita 2, Kansas

FIGURES INDICATE BOTTOM OF FORMATION

0	to	155	Sand
155		235	Shale
235		270	Sand
270		310	Shale
310		360	Sand Shale
360		490	Shale and Shells
490		640	Red Bed
640		720	Shale and Red Bed
720		765	Red Bed
765		790	Anhydrite Lime
790		1500	Shale, shells and salt
1500		1755	Red Bed
1755		2085	Lime
2085		2165	Lime and Shells
2085		2520	Lime and Shale
2520		2815	Shale and Lime Shells
2815		3185	Shale and Lime
3185		3475	Lime
3475		3550	Shale
3550		3595	Lime and Shale
3595		3960	Lime
3960		4105	Lime and Chert
4105		4122	Lime
4122		4138	Simpson Shale
4138		4210	Lime
		4210	TD

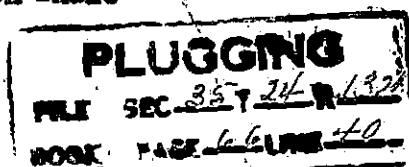

STATE OF KANSAS)

COUNTY OF SEDGWICK)

I, the undersigned, being duly sworn on oath, depose and state that the above statement and log is a true and correct record of the well drilled by John Lindas Oil, Inc., at the location above described.

Edward W. Wiene

Subscribed and sworn to before me this 19th day of December, 1952.

Ruth H. Vesket
Notary Public

My Commission Expires:

My Commission Expires Nov. 5, 1955