


Give All Information Completely
Make Required Affidavit
Mail or Deliver Report to:
Conservation Division
State Corporation Commission
211 No. Broadway
Wichita, Kansas

WELL PLUGGING RECORD

Stafford County, Sec. 36 Twp. 24 Rge. (E) 13 (W)

Location as "NE/CNW/SW" or footage from lines NE NW NE
Lease Owner Woodman & Iannitti Drilling Co.
Lease Name Kirkpatrick Well No. 1
Office Address 706 Union National Bldg.
Character of Well (completed as Oil, Gas or Dry Hole) Dry Hole
Date well completed 4-13 19 65
Application for plugging filed 4-13 19 65
Application for plugging approved 4-13 19 65
Plugging commenced 4-13 19 65
Plugging completed 4-13 19 65
Reason for abandonment of well or producing formation Dry

NORTH

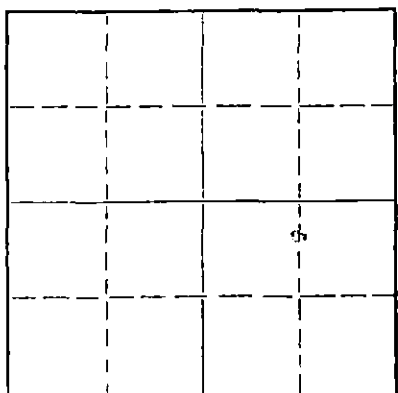

Locate well correctly on above Section Plat

If a producing well is abandoned, date of last production 19
Was permission obtained from the Conservation Division or its agents before plugging was commenced? Yes

Name of Conservation Agent who supervised plugging of this well Archie V. Elving
Producing formation Depth to top Bottom Total Depth of Well 4169 Feet
Show depth and thickness of all water, oil and gas formations.

OIL, GAS OR WATER RECORDS

CASING RECORD

FORMATION	CONTENT	FROM	TO	SIZE	PUT IN	PULLED OUT
				8 5/8	244'	

Describe in detail the manner in which the well was plugged, indicating where the mud fluid was placed and the method or methods used in introducing it into the hole. If cement or other plugs were used, state the character of same and depth placed, from feet to feet for each plug set.

Bottom Plug @ 230 w/25 sx
Top Plug @ 40 w/10 sx

RECEIVED
STATE CORPORATION COMMISSION

APR 14 1965

CONSERVATION DIVISION
Wichita, Kansas

(If additional description is necessary, use BACK of this sheet)
Name of Plugging Contractor Woodman & Iannitti Drilling Co.
Address 706 Union National Building

STATE OF Kansas, COUNTY OF Sedgwick, ss.
K. T. Woodman (employee of owner) or (owner or operator) of the above-described

well, being first duly sworn on oath, says: That I have knowledge of the facts, statements, and matters herein contained and the log of the above-described well as filed and that the same are true and correct. So help me God.
(Signature) K. T. Woodman

706 Union National Bldg.
(Address)

SUBSCRIBED AND SWORN TO before me this 13 day of April, 1965

My commission expires Feb. 11, 1968
Justina Chamberlain
Notary Public.

15-185-30215-0000

KANSAS GEOLOGICAL SOCIETY
KANSAS WELL LOG BUREAU - KANSAS WELL SAMPLE BUREAU
KANSAS GEOLOGICAL SOCIETY BUILDING
508 EAST MURDOCK - WICHITA, KANSAS

COMPANY Woodman & Iannitti Drilling Co.

SEC. 36 T. 24 R. 13W
LOC. NE NW NE

FARM Kirkpatrick NO. 1

TOTAL DEPTH 4169'

COUNTY Stafford

COMM. 4-3-65


COMP. 4-13-65

KANSAS

SHOT OR TREATED

CONTRACTOR Woodman & Iannitti Drilling Co.

ISSUED

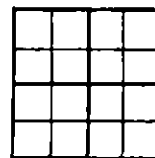

CASING

20 10
15 8 5/8 @ 244' w/200 sx
12 6
13 5

ELEVATION 1919 KB

PRODUCTION

FIGURES INDICATE BOTTOM OF FORMATIONS

190 Sand
210 Red Bed
248 Blue Shale & Grey Shale
415 Red Bed & Shale
725 Red Bed
865 Anhy
1040 Shale
1520 Shale & Shells
1660 Shale & Shells
1805 Shale & Lime
1945 Lime & Shale
2050 Lime
2240 Lime & Shale
2350 Lime & Shale
2500 Lime
2690 Lime & Shale
2835 Lime
2985 Lime
3140 Lime & Shale
3220 Lime
3295 Lime
3380 Lime
3449 Lime
3580 Lime
3666 Lime
3685 Lime
3740 Lime
3800 Lime
3844 Lime
3905 Lime
3955 Lime & Chert
4023 Lime & Sheli & Chert
4064 Chert & Hard Lime
4104 Lime & Chert
4169 Total Depth

RECEIVED
STATE CORPORATION COMMISSION

APR 14 1965

CONSERVATION DIVISION
Wichita, Kansas

I certify the above to be a true and correct copy of the driller's log and the geological tops to the best of my knowledge and belief.

WOODMAN & IANNITTI DRILLING CO.

By. K. T. Woodman

K. T. Woodman