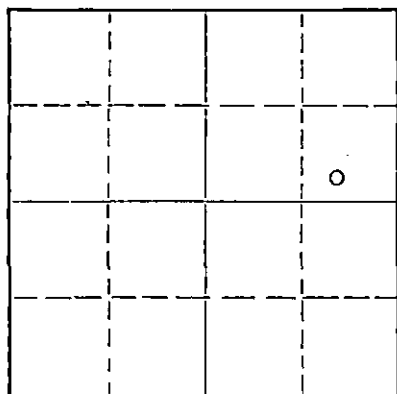


Give All Information Completely
Make Required Affidavit
Mail or Deliver Report to:
Conservation Division
State Corporation Commission
800 Bittig Building
Wichita, Kansas

WELL PLUGGING RECORD

NORTH

Locate well correctly on above
Section Plat

Stafford County, Sec. 29 Twp. 24S Rge. (E) 14 (W)

Location as "NE/CNW%SW%" or footage from lines SW SE NE
Lease Owner Natural Gas and Oil Co, a division of Mississippi
Lease Name River Fuel Corp. De Busk Well No. 1
Office Address 1009 Central Building, Wichita, Kansas
Character of Well (completed as Oil, Gas or Dry Hole) dry hole
Date well completed September 16, 1954 19
Application for plugging filed Orally- September 16, 1954 19
Application for plugging approved September 16, 1954 19
Plugging commenced September 16, 1954 19
Plugging completed September 16, 1954 19
Reason for abandonment of well or producing formation

If a producing well is abandoned, date of last production 19
Was permission obtained from the Conservation Division or its agents before plugging was commenced? yes

Name of Conservation Agent who supervised plugging of this well M. A. Rives, Box 8, Pratt, Kansas
Producing formation Depth to top Bottom Total Depth of Well Feet
Show depth and thickness of all water, oil and gas formations.

OIL, GAS OR WATER RECORDS

CASING RECORD

FORMATION	CONTENT	FROM	TO	SIZE	PUT IN	PULLED OUT
surface	Sd-sh & shells	0	214	10 3/4	214	none

Describe in detail the manner in which the well was plugged, indicating where the mud fluid was placed and the method or methods used in introducing it into the hole. If cement or other plugs were used, state the character of same and depth placed, from feet to feet for each plug set.

Filled hole with heavy mud from TD 4365 to 205 feet. Set plug at 205 feet and ran 25 sacks cement to 155 feet.
Filled hole with heavy mud from 155 to 35 feet
Set plug at 35 feet and capped with 15 sacks cement.

9-20-54

(If additional description is necessary, use BACK of this sheet)

Name of Plugging Contractor Drilling department of Natural Gas and Oil Company, a
Address division of Mississippi River Fuel Corporation, Route #1
Great Bend, Kansas

STATE OF Kansas, COUNTY OF Sedgwick, ss.
John D. Carey (employee of owner) of the above-described well, being first duly sworn on oath, says: That I have knowledge of the facts, statements, and matters herein contained and the log of the above-described well as filed and that the same are true and correct. So help me God.

(Signature)

1009 Central Bldg, Wichita 2, Kansas
(Address)

SUBSCRIBED AND SWORN TO before me this 18th day of September 19 54

My commission expires May 25, 1957

Esther Unsell.

Notary Public.

PLUGGING
FILED SEC 29 T24 R14W
BOOK PAGE 67 LINE 31

driller's log

COMPANY: Natural Gas and Oil Company, a
Division of Mississippi River
Fuel Corporation

CONTRACTOR: Drilling Department of
Natural Gas and Oil Company

FARM: De Busk #1, SW SE NE Sec. 29-24S-14W
Stafford County, Kansas

COMMENCED: September 1, 1954

COMPLETED: September 16, 1954

ELEVATION: 1988 R.B.

0	to	155	Sand
155	to	350	Shale and shells
350	to	800	Red Bed and shale
800	to	930	Shale and shells
930	to	950	Anhydrite
950	to	1645	Shale and shells
1645	to	3355	Shale and lime
3355	to	3504	Lime
3504	to	3675	Shale and lime
3675	to	3694	Shale
3694	to	3953	Lime
3953	to	4088	Lime and shale
4088	to	4181	Lime
4181	to	4216	Cherty lime and shale
4216	to	4263	Chert and lime
4263	to	4336	Lime and shale
4336	to	4365	Arbuckle lime
		4365	T. D.

Set 213 feet of 10 3/4" surface pipe.
Cemented with 200 sacks cement, 6% calcium chloride.

TOPS: Anhydrite 930 Lansing 3715 Simpson 4275
Heebner 3552 Mississippi 4095 Arbuckle 4337
Brown Lime 3694 Viola 4189

DRILLSTEM TESTS:

#1 - 3738-62, open 1 hour, rec. 140 ft sl oil and gas
cut watery mud, SI 20 min, IFP and FFP 0#
BHP 1115#.

#2 - 3843-56, open 1 hr, strong to weak blow 38 min,
rec. 45 ft mud, SI 20 min, IFP & FFP 0#,
BHP 630#.

No Schlumberger
DRY, PLUGGED AND ABANDONED

9-20-54

C E R T I F I C A T E

I, John D. Carey, do hereby certify that the above and foregoing is a true and correct copy of the log of the De Busk #1, SW SE NE Section 29, 24S-14W, Stafford County, Kansas, as reflected by files of the Natural Gas and Oil Company, a division of Mississippi River Fuel Corporation.

PLUGGING

FILE SEC 29-24-14W
BOOK PAGE 64 LINES 31

John D. Carey
John D. Carey

Subscribed and sworn to before me, a Notary Public,
within and for Sedgwick County, Kansas, this 18th day
of September, 1954.

Esther Unsell
Esther Unsell, Notary Public

My commission expires May ;25, 1957.