

STATE OF KANSAS
STATE CORPORATION COMMISSION


Give All Information Completely
Make Required Affidavit
Mail or Deliver Report to:
Conservation Division
State Corporation Commission
800 Biting Building
Wichita, Kansas

15-167-45887-0000
WELL PLUGGING RECORD

OR
FORMATION PLUGGING RECORD

Strike out upper line
when reporting plug-
ging off formations.

NORTH

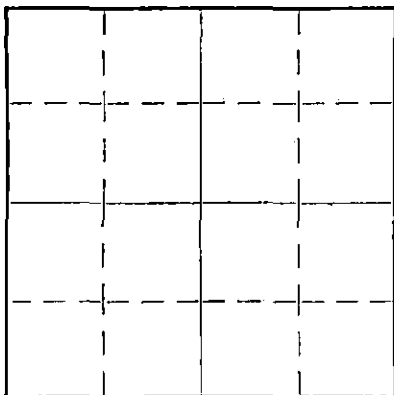

Locate well correctly on above
Section Plot

Russell County. Sec. 34 Twp. 15 Rge. 15 (W)
Location as "NE $\frac{1}{4}$ NW $\frac{1}{4}$ SW $\frac{1}{4}$ " or footage from lines NE corner SE $\frac{1}{4}$ NW $\frac{1}{4}$
Lease Owner The Boyle Grossman Drilling Co.
Lease Name Steinert Well No. 1
Office Address 139 N. Mead Ave., Wichita, Kansas
Character of Well (Completed as Oil, Gas or Dry Hole) Dry Hole
Date, well completed Aug. 3, 1937 193
Application for plugging filed Aug. 16, 1937 193
Application for plugging approved Aug. 16, 1937 193
Plugging Commenced Aug. 16, 1937 193
Plugging Completed Aug. 25, 1937 193
Reason for abandonment of well or producing formation
dry hole, no production
If a producing well is abandoned, date of last production 193
Was permission obtained from the Conservation Division or its agents before plugging was commenced?
yes

Name of Conservation Agent who supervised plugging of this well C.T. Alexander
Producing formation Depth to top Bottom Total Depth of Well 3460 Feet.

Show depth and thickness of all water, oil and gas formations.

OIL, GAS OR WATER RECORDS


CASING RECORD

Formation	Content	From	To	Size	Put In	Pulled Out
				15 $\frac{1}{2}$ "	294'	294'
				12 $\frac{1}{2}$ "	412'	412'
				10"	961'	961'
				8 $\frac{1}{2}$ "	2820'	2790'
				6 5/8"	3261'	3261'

Describe in detail the manner in which the well was plugged, indicating where the mud fluid was placed and the method or methods used in introducing it into the hole. If cement or other plugs were used, state the character of same and depth placed, from feet to feet for each plug set.

Filled with mud to 330'
Cement ~~saxa~~ plug at 330'

Filled to top with mud and cement cap.

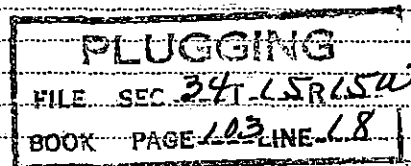

(If additional description is necessary, use BACK of this sheet)

Correspondence regarding this well should be addressed to The Boyle Grossman Drilling Co.,
Address 139 N. Mead Ave., Wichita, Kan.

STATE OF Kansas, COUNTY OF Sedgwick, ss.

I. L. Grossman, Vice-President (employee of owner) or (owner or operator) of the above-described well,
being first duly sworn on oath, says: That I have knowledge of the facts, statements, and matters herein contained and the log of the above-described well as filed and that the same are true and correct. So help me God.

(Signature)

139 N. Mead Ave., Wichita, Kan.

(Address)

SUBSCRIBED AND SWORN to before me this 5th day of January, 1938.

My commission expires November 5, 1938.

Description:

NEC 3E2 NW4
Sec. 34-15-15W
Russell Co., Ks.

Commenced April 8, 1937
Completed Aug. 3, 1937

Log of Steinert #1
being drilled by
THE BOYLE CROSBYMAN DRILLING CO.
130 N. Mead Ave.
Wichita, Kansas.

Casing record:

15 1/2" set 294'
12 1/2" " 412'
10" " 830 u/r 961'
8 1/2" " 2225 u/r 2920'
6 5/8" 3143 u/r 3261'

Formation Total Depth

Clay	25	
Clay, sandy	40	
Lime	65	
Shale, dark	70	
Shale	130	
Shale, dark	200	
Shale, gray, sandy	215	1/2 NW 220' 2 NW 230'
Lime, sandy	230	
Water sand	272	NFW 250-272'
Shale, red	290	
Shale, blue	295	
Shale, brown	310	
Shale, red	320	
Shale, bluetred	350	
Lime	370	
Red rock	385	
Shale, blue	435	
Slate, blue	465	
Water sand	490	NFW 465'
Slate	500	
Sand	535	
Water sand, red	575	
Sand, red	605	
Sand	625	
Shale, sandy	640	
Sandy, red	660	
Shale, sandy	685	
Sandy, red	700	
Shale, sandy, red	720	
Shale, red	757	
Sandy, red	795	
Shale, red	810	
Shale, red	830	
Sandy, red	855	
Red rock	895	
Shale, red	945	
Lime	947	
Shale, red	960	
Lime	1000	
Shale, red	1175	
Slate, blue	1230	
Shale, red	1275	
Shale, red & blue	1305	
Shale, blue	1335	
Slate, blue	1365	
Shale, salt & shells	1390	
Salt & shale	1430	
Salt	1470	
Salt & shale	1510	
Salt	1550	
Slate, blue	1560	
Lime	1565	
Salt	1660	
Salt & shale	1670	
Shale	1680	
Lime	1720	
Lime, broken	1745	
Lime	1765	
Red rock	1790	
Slate & shells	1815	
Shale	1825	
Shale & shells	1845	
Slate	1860	
Lime, sandy	1895	
Shale	1900	
Shale, red	1910	
Shale & shells	1935	
Shale	1955	

Formation Total Depth

Slate & shells	1975	
Lime, sandy	2005	
Shale, blue	2015	
Lime	2035	
Lime, sandy, sharp	2050	
Shale, blue	2065	
Red rock	2075	
Lime	2235	
Red rock	2090	1/2 NW 2155'
Lime	2160	
Shale, green	2170	
Lime	2180	
Lime, sandy	2215	
Lime	2225	
Shale	2235	
Lime	2260	
Red rock	2270	
Lime	2325	
Shale & shells	2340	
Lime	2355	
Slate, sandy	2375	
Lime	2380	
Shale & shells	2405	
Slate, blue & shells	2440	
Shale, blue	2505	
Shale	2520	
Slate & shells	2530	
Red rock, trace		
Shale, blue	2555	
Red rock	2565	
Shale, blue	2620	
Lime	2630	
Shale	2655	
Shale, blue	2665	
Lime	2680	
Slate	2695	
Lime	2705	
Lime, --	2710	
Shale	2720	
Lime	2735	
Shale, brown	2745	
Lime	2750	
Slate	2770	
Lime	2780	
Shale	2800	
Lime	2805	
Lime	2810	
Lime	2820	
Slate	2835	
Shale	2845	
Slate	2860	
Lime	2875	
Shale	2895	
Lime	2925	
Slate	2930	
Lime, sandy	2935	
Lime	3115	1/2 NW 3085'
Slate, black	3120	
Lime	3125	
Slate & lime shells	3135	
Lime	3150	
Red rock	3157	
Shale	3170	
Lime	3191	
Shale	3195	NFW 3155'
Lime	3235	3200
Lime, hard	3250	Light show
Lime	3262	oil 3266'

PLUGGING
FILE SEC-34-T-15-15W
BOOK PAGE 103 E-18

Log of #1 Steinhert (cont'd)

Formation	Total Depth
Lime, hard	3257 HFW 3257-62'
Lime	3272
Lime, white	3273
Lime	3288
Lime, sandy	3300
Lime	3312
Shale	3315
Lime	3376
Shale, black	3377
Lime	3390
Shale	3397
Lime	3400
Lime, broken	3415
Shale, var. color	3420
Red rock, shale	
lime	3426
Lime, sharp, sandy	3430
Lime, sandy	3437
Lime, sharp, sandy	3450
Lime	3460 HFW

Hole full of water

AFFIDAVIT

STATE OF KANSAS }
COUNTY OF SEDGWICK } SS:

O. A. Boyle, President of The Boyle Crossman Drilling Company, hereby certifies that the log incorporated herewith is a true and correct copy of the daily drilling record kept by the drillers and to the best of their knowledge is a correct description of the formations encountered in drilling the #1 test on the Steinhert lease located in the northeast corner of the Southeast Quarter (SE₁) of the Northwest Quarter (NW₄) of Section 34, Township 15, Range 15 West, Russell County, Kansas; that the total depth is 3460 feet at which depth a hole full of water was encountered.

O. A. Boyle

Subscribed and sworn to before me
this 5th day of August, 1937.

PLUGGING			
FILE	SEC	T	R
		34	15
BOOK	PAGE	LINE	
	103	18	

By Bell
Notary Public

My commission expires Nov 5, 1938.