


STATE OF KANSAS
STATE CORPORATION COMMISSION

Give All Information Completely
Make Required Affidavit
Mail or Deliver Report to:
Conservation Division
State Corporation Commission
800 Bittling Building
Wichita, Kansas

WELL PLUGGING RECORD
OR 15-167-08034-000
FORMATION PLUGGING RECORD

Strike out upper line
when reporting plug-
ging off formations.

NORTH

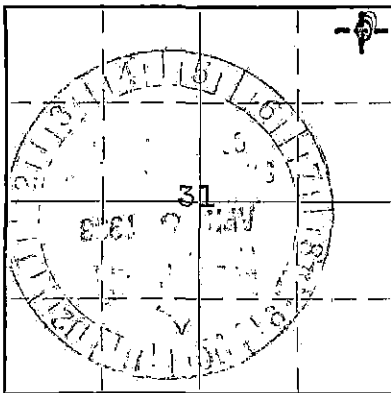

Locate well correctly on above
Section Plat

Russell County. Sec. 31 Twp. 15 Rge. 15 (W) (W)
Location as "NE1/4NW1/4SW1/4" or footage from lines Ne/4 NE/4
Lease Owner Vernon Oil Co. & I.W. Murfin
Lease Name Pearson Well No. 1
Office Address Union National Bank Bldg, Wichita, Kansas
Character of Well (Completed as Oil, Gas or Dry Hole) Dry
Date, well completed December 24th 1937
Application for plugging filed December 31st. 1937
Application for plugging approved December 31st. 1937
Plugging Commenced December 31st. 1937
Plugging Completed April 1st. 1938 1938
Reason for abandonment of well or producing formation

If a producing well is abandoned, date of last production 193
Was permission obtained from the Conservation Division or its agents before plugging was commenced?
Yes

Name of Conservation Agent who supervised plugging of this well C.T. Alexander
Producing formation Depth to top Bottom Total Depth of Well 3480 Feet.

Show depth and thickness of all water, oil and gas formations.

OIL, GAS OR WATER RECORDS

CASING RECORD

Formation	Content	From	To	Size	Put In	Pulled Out
				6 5/8	3198'	3198'
				8 1/4	2660'	2660'
				10"	1000'	1000'
				12 1/2	631'	575'
				15 1/2	343'	185'

Describe in detail the manner in which the well was plugged, indicating where the mud fluid was placed and the method or methods used in introducing it into the hole. If cement or other plugs were used, state the character of same and depth placed, from feet to feet for each plug set.

Filled with mud from 3480 feet to 3000 feet, pulled in from slush pond, using a steel drum on the sand line. Bridged hole at 1025' with wood plug and 10' of rock then put in 15' of cement, cement dumped in with dump bailer. Put in mud from slush pond from cement plug 1000' to top of hole. Capped with 15 sacks of cement then filled cellar to top.

31.15.15W
BOOK PAGE 2 LINE 22

(If additional description is necessary, use BACK of this sheet)

Correspondence regarding this well should be addressed to Vernon Oil Co. or I.W. Murfin
Address Wichita, Kansas

STATE OF Kansas, COUNTY OF Sedgwick, ss.

(employee of owner) or (owner or operator) of the above-described well,
being first duly sworn on oath, says: That I have knowledge of the facts, statements, and matters herein contained and the log of the above-described well as filed and that the same are true and correct. So help me God.

(Signature)

I. W. Murfin

(Address)



Subscribed and Sworn to before me this 4th day of April, 1938.

My commission expires April 23rd, 1941

Fanchon A. Cassidy

Notary Public.


WELL LOG BUREAU - KANSAS GEOLOGICAL SOCIETY.
412 Union National Bk Bldg., Wichita, Kansas.

VERNON OIL & GAS CO.
Pearson No. 1.

SEC. 31 T. 15 R. 15W
NE NE NE

Total Depth. 3480'
Comm. 10-21-37 Comp. 12-24-37
Shot or Treated.
Contractor. I.W. Murfin
Issued. 1-8-38

County. Russell

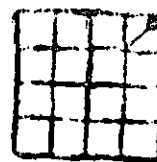

CASING:

15 1/2" 343'
12 1/2" 602' UR 631'
10 " 1000'
8 1/2" 2345' UR 2556' 8"
6 5/8" 3198'
5 3/16" liner 3464'

Elevation.

Production. Dry

Figures Indicate Bottom of Formations.

sand rock shells	15	red rock	2305	shale	3273
mud	40	lime	2350	lime	3295
shale	165	shale	2353	lgt sh oil 3290-92	
sand	215	lime	2355	shale	3300
shale	225	red rock	2375	lime	3377
sand	310	lime	2408	red rock	3380
shale	320	shale	2411	lime	3389
shale sdy	340	lime	2455	lgt sh oil 3381-83	
lime shells	343	shale & lime shells	2470	inc in oil 3384-86	
shale	390	lime	2475	shale	3392
sand wtr	400	shale	2480	lime	3403
shale	430	lime	2490	shale	3406
sand	440	shale	2500	conglomerate, & lime	
shale	475	lime	2515	shells	3412
sand & shale	490	shale & shells	2545	lime	3427
sdv shale	500	shale	2560	shale break	3429
sand	510	lime	2570	show oil 3430	
red rock	520	shale & shells	2605	inc in oil 3431	
sand	545	shale	2610	lime	3431
red rock	550	lime	2620	conglomerate lime	3436
sand	575	shale	2662	conglomerate	3468
shale	580	2650 equals 2660		lime	3480
sand	590	lime	2663	Total Depth.	
shale	604	lime & iron	2665		
red bed sdy	606	shale	2669		
red rock	625	lime	2675	Wtr Record	
shale	640	shale	2677	HFV 170	
red rock	770	lime	2685	HFV 430-440	
red rock sdy	790	shale	2695	HFV 770-790	
red rock	975	lime	2700	1 1/2 BW 2375	
gyp	985	shale	2717	1 1/2 BW 3060	
lime	1030	lime	2735	1 1/2 BW 3100	
red rock	1205	shale	2740	1 1/2 BW 3120	
shale	1250	lime shells	2770	1 1/2 BW 3230-3235	
red rock	1300	shale & shells	2785	More W at 3464	
shale	1365	lime	2795	HFV 3475-3480	
salt & shale	1435	shale	2800		
salt	1675	lime	2810		
shale & lime shells	1720	shale	2818		
lime	1805	lime	2825		
shale	1810	shale	2852		
shale & lime shells	1835	2855 equals 2853			
lime brkn	1855	lime	2868		
lime & shale	1905	shale	2877		
shale	1935	lime	2940		
red rock	1940	shale	2945		
lime	1960	lime	3002		
lime brkn	1980	shale	3007		
lime	2085	lime	3138		
red rock	2090	shale	3141		
lime	2165	lime	3144		
shale	2175	shale	3150		
lime brkn	2210	shale & shells	3158		
lime	2260	lime	3175		
shale	2265	shale	3177		
lime	2275	red rock	3193		
lime brkn	2285	lime	3270		



STATE OF KANSAS

SS

COUNTY OF SEDGWICK

Personally appeared before me, the undersigned authority for
administering oath, one I. W. Murfin who deposes and says: that
he was the drilling contractor and that the foregoing is a true
and correct ^{copy} of the copy of the log of the well drilled in the
Northeast corner of the Northeast Quarter of Section 31, Township
15, Range 15 West, Russell County, Kansas.

Further affiant saith not.

I. W. Murfin

Subscribed and sworn to before me this 31st day of December, 1937.

Lanahan A. Cassidy
Notary Public

My commission expires March 25rd, 1941