

15-091-19232-00-00

STATE OF KANSAS
STATE CORPORATION COMMISSION

WELL PLUGGING RECORD


FORMATION PLUGGING RECORD

Give All Information Completely
Make Required Affidavit
Mail or Deliver Report to:
Conservation Division
State Corporation Commission
800 Bittling Building
Wichita, Kansas

OR

Strike out upper line
when reporting plug-
ging off formations.

NORTH

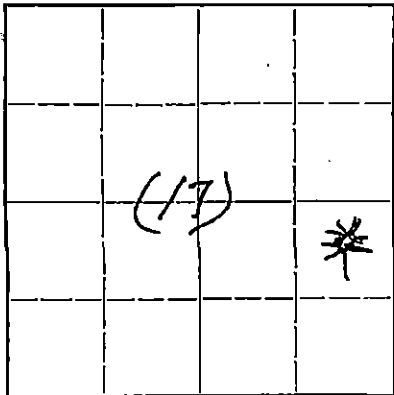

Locate well correctly on above
Section Flat

Johnson County. Sec. 17 Twp. 13 Rge. 23 (E) (W)
Location as "NE $\frac{1}{4}$ NW $\frac{1}{4}$ SW $\frac{1}{4}$ " or footage from lines 510' from N. Line, 750' from E. line
Lease Owner Sagamore Oil & Gas Co. of S.E. $\frac{1}{4}$
Lease Name Metropolitan Life Ins. Co. Well No. 4
Office Address Independence, Kansas
Character of Well (completed as Oil, Gas or Dry Hole) Gas
Date well completed 9-5-35 19
Application for plugging filed 4-15 19
Application for plugging approved 4-15 19
Plugging commenced 4-30-46 19
Plugging completed 4-30-46 19
Reason for abandonment of well or producing formation Dead
If a producing well is abandoned, date of last production 19
Was permission obtained from the Conservation Division or its agents before plugging was commenced? Yes

Name of Conservation Agent who supervised plugging of this well A. L. Sides
Producing formation Knobtown Depth to top 339' Bottom 349' Total Depth of Well 351' Feet
Show depth and thickness of all water, oil and gas formations.

OIL, GAS OR WATER RECORDS

CASING RECORD

Formation	Content	From	To	Size	Put In	Pulled Out
Sand	Gas	339'	349'	8 $\frac{1}{2}$ "	29'	None

Describe in detail the manner in which the well was plugged, indicating where the mud fluid was placed and the method or methods used in introducing it into the hole. If cement or other plugs were used, state the character of same and depth placed, from _____ feet to _____ feet for each plug set.

- 1" Tubing pulled out
- 2" " shot off at top of 2" packer
- 2" Pulled up 4'
- 3 Sacks of cement poured down 2" on top of packer
- 2" tubing was pulled

Hole bridged 30' from top and filled with mud and rock to top, 8 $\frac{1}{2}$ " drive pipe left in.

PLUGGING
TWP 17.13 RGE 23E
LOOK AREA 54-18

MAY 13 1946
5-13-46

(If additional description is necessary, use BACK of this sheet)

Correspondence regarding this well should be addressed to Sagamore Oil and Gas Company, Independence, Kansas
Address

STATE OF KANSAS
STATE CORPORATION COMMISSION
CONSERVATION DIVISION
800 BITTING BUILDING
WICHITA, KANSAS

WELL PLUGGING APPLICATION FORM

Well Location NESE Olathe Sec. 17 Twp. 13 Rge. 23 (E) (W)

Field Name (if any) _____ County Johnson

Lease (Farm Name) Metropolitan Life Ins. Co. Well No. 4

Was well log filed with application? Yes If not, explain circumstances and give available data (Use an additional sheet if necessary)

Date and hour plugging is desired to begin 4-30-46 8 AM

Plugging of the well will be done in accordance with the Rules and Regulations of the State Corporation Commission, or with the approval of the following exceptions: Explain fully any exceptions desired (Use an additional sheet if necessary)

Name of the person on the lease in charge of well for owner _____

Geo. C. Priestley Address Olathe, Kansas


Name of well owner or Acting Agent Sagamore Oil & Gas Co.

Address Independence, Kansas

Invoice covering assessment for plugging this well should be sent to:

Sagamore Oil & Gas Co. Address Independence, Kansas

and payment will be guaranteed by applicant.

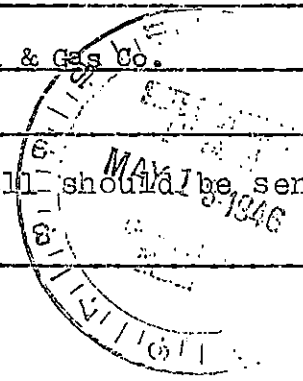

Geo. C. Priestley
Operator or Acting Agent

Date 4-30-46

17 13 23E
54 18



STATE OF KANSAS
STATE CORPORATION COMMISSION
CONSERVATION DIVISION
800 BITTING BUILDING
WICHITA 2, KANSAS

May 15, 1946

IN REPLY PLEASE
REFER TO THIS
SUBJECT

Well No. 4
Lease Metropolitan Life Ins. Co.
Description NE 1/4 17-15-33E
County Johnson
File: 54-18

Edgmore Oil & Gas Co.
Independence, Kansas

Gentlemen:

This letter is your permit to plug the above subject well, in accordance with the Rules and Regulations of the State Corporation Commission.

Very truly yours,

STATE CORPORATION COMMISSION
CONSERVATION DIVISION

HA

BY: J. P. Roberts
J. P. ROBERTS

NOTICE: A. L. Sides
Osawatomie, Kansas

H

DISTRICT CONSERVATION AGENT'S REPORT

TO:

State Corporation Commission
Conservation Division
800 Bitting Building
Wichita, Kansas

FILE NO. _____

LOCATION N 8 1/4 S 8 1/4

SEC. 17 TWP. 13 RGE. 23

Dry Hole _____ Abandoned Oil Well _____ Abandoned Gas Well X

I have today completed supervision of plugging of:

Well No. 4 Lease Metropolitan Life Ins Co

Operator Sagamore Oil & Gas Co Address Independence Kan


Field Olathe County Johnson

Total Depth 351 Feet.

(Describe briefly the manner in which the well was plugged)

Three sacks cement put in on
top of casing at 335 ft

Hole bridged at 30 ft. Hole filled
to surface

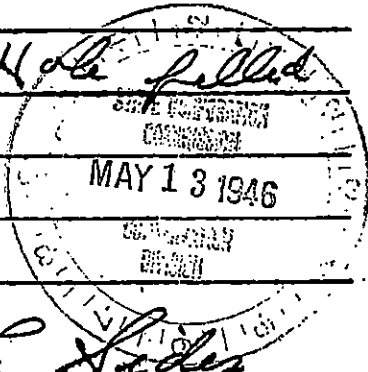

A. L. Hodes
District Conservation Agent

Date 4-30-1946

PLUGGING
FILE SEC-17-13-23E
BOOK PAGE 54 LINE 18

SAGAMORE OIL AND GAS COMPANY

INDEPENDENCE, KANSAS

Company Sagamore Oil and Gas Company

S. T. R. 17-18-23
 County Johnson
 State Kansas
 Lease and Well No. Metropolitan L.I.C.
 #4


Contractor B. Earl Smith

Drilling Commenced 9/2/35 Drilling Completed 9/5/35

Initial Production gas well Initial Rock Pressure


Location 510' from N line, 750' from E line of SE 1/4

Casing 8 1/2" 29'

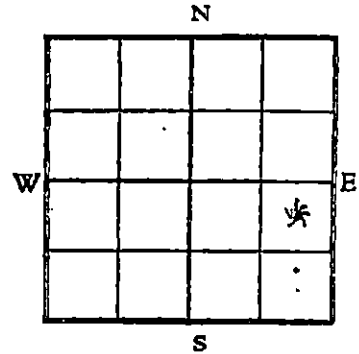

Driller's Record of Formations

shell lime	7	7
yellow clay	4	11
gravel	4	15
shale green	13	28
lime	28	56
shale	1	57
lime	27	84
shale	47	131
lime	6	137
shale	2	139
lime	4	143
shale	11	154
lime	2	156
shale	4	160
lime	8	168
shale	17	185
lime	19	204
shale	2	206
lime	2	208
shale dark	4	212
lime sharp	15	227
shale	2	229
lime	18	247
shale black	5	252
lime	21	273
shale	4	277
lime	2	279
shale	4	283 SIM
lime	7	290 Reduced hole at 290
shale	27	317
lime	1	318
sand	5	323
sand	5	328
sand	1	329
shale	10	339
sand	10	349
shale	2	351 T.D.

 

17 13 23E
 54 18