

15-187-30000-00-00

9

STATE OF KANSAS
STATE CORPORATION COMMISSION

Form CP-4

Give All Information Completely
Make Required Affidavit
Mail or Deliver Report to:
Conservation Division
State Corporation Commission
212 No. Market
Wichita, Kansas 67202

WELL PLUGGING RECORD

Stanton County, Sec. 36 Twp. 28S Rge. (E) 39 (W)

Location as "NE/CNWSW" or footage from lines 660' FN & EL SW/4

Lease Owner Atlantic Richfield Company

Lease Name Fred Shore Unit Well No. 2

Office Address P.O. Box 521 - Tulsa, Oklahoma

Character of Well (completed as Oil, Gas or Dry Hole) Gas

Date well completed January 8, 1965

Application for plugging filed December 17 19 71

Application for plugging approved (Verbally) December 20 19 71


Plugging commenced December 22 19 71

Plugging completed December 22 19 71

Reason for abandonment of well or producing formation Unable to get well to produce

If a producing well is abandoned, date of last production None 19

Was permission obtained from the Conservation Division or its agents before plugging was commenced? Yes

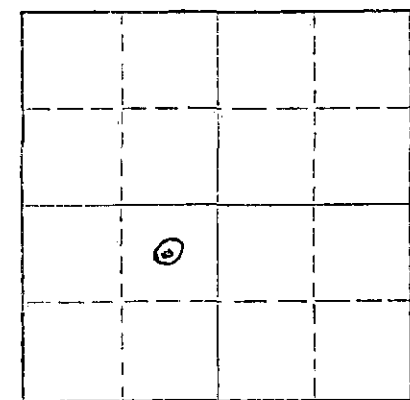

Locate well correctly on above Section Plat

Name of Conservation Agent who supervised plugging of this well Ed Eves

Producing formation Council Grove Depth to top 2596' Bottom 2849 Total Depth of Well 3042 Feet

Show depth and thickness of all water, oil and gas formations.

OIL, GAS OR WATER RECORDS

CASING RECORD

FORMATION	CONTENT	FROM	TO	SIZE	PUT IN	PULLED OUT
Chase		2294'	2596'	8-5/8"	592'	None
Council Grove		2596'	2849'	4-1/2"	3042'	None

Describe in detail the manner in which the well was plugged, indicating where the mud fluid was placed and the method or methods used in introducing it into the hole. If cement or other plugs were used, state the character of same and depth placed, from 2874 feet to 60 feet for each plug set.

Mixed and pumped in 410 sx. cement filling 4-1/2" casing from plugged back depth of 2874' to 60 feet. Welded plate on 8-5/8" casing 3' below ground level.

RECEIVED
STATE CORPORATION COMMISSION
JAN 17 1972
CONSERVATION DIVISION
Wichita, Kansas
1-17-72

(If additional description is necessary, use BACK of this sheet)

Name of Plugging Contractor Halliburton Services

Address Liberal, Kansas

STATE OF Oklahoma COUNTY OF Tulsa, ss.

Keith L. Diehl (employee of owner) or (owner or operator) of the above-described

well, being first duly sworn on oath, says: That I have knowledge of the facts, statements, and matters herein contained and the log of the above-described well as filed and that the same are true and correct. So help me God.

(Signature) Keith L. Diehl

P. O. Box 521 - Tulsa, Oklahoma 74102

(Address)

SUBSCRIBED AND SWORN TO before me this 14th day of January, 19 72

My commission expires Oct. 15, 1974

Patsy L. Langton
Notary Public.

LEASE: FRED SHORE UNIT (WN), WELL #2 LOCATION: 660' FN & EL of SW/4
 OWNER: SINCLAIR OIL & GAS COMPANY SECTION 36-28S-39W
 CONT: EARL F. WAKEFIELD STANTON CO., KANSAS
 CORR: 11-29-64 CASING: 8 5/8" Set @ 592'
 COMP: 12-6-64 4 1/2" Set @ 3042'

Sand and Clay	480
Red Bed	970
Sand - Red Bed	1020
Sand	1130
Shale	1237
Shale & Shells	2010
Lime & Shale	2560
Lime With Streaks Shale	2635
Lime & Shale	2894
Lime W/Streaks Shale	2975
Lime	3042
T.D.	3042

Perforated 4 1/2" OD casing opposite Council Grove 2582-96', 2632-40', 2644-48', 2711-19', 2742-49', 2772-80' and 2812-20' 2 holes per foot, total 100 holes. Treated Council Grove thru casing perfs. w/ 2000 gallons 15% acid w/ 125 ball sealers, max. press. 1300#, min. pr. 600# on vacuum in 5 minutes. Avg. inj. rate 20.4 bbls. per minute. Also treated Council Grove thru casing perf. w/ 150,000 gallons jet water and 75,000# river sand. Max. pr. 2200#, min. pr. 1700# on vacuum 5 minutes after treatment Avg. injection rate 79 Bbls. per minute

STATE OF KANSAS)
) SS
 COUNTY OF SEDGWICK)

I, FRED S. BARKER, DO HEREBY CERTIFY THAT THE ABOVE IS A TRUE AND CORRECT COPY OF THE DRILLER'S LOG ON THE FRED SHORE UNIT (WN) WELL NO. 2, LOCATED 660' from the North and East lines of the SW/4 of SECTION 36-28S-39W, STANTON COUNTY, KANSAS.

EARL F. WAKEFIELD

BY Fred S. Barker

SUBSCRIBED AND SWORN TO BEFORE ME THIS 11th DAY OF DECEMBER, 1964.

MY COMMISSION EXPIRES:
 JANUARY 25, 1965

Wanda D. Riley
 NOTARY PUBLIC

Completed as dry gas well with open flow potential of 4,750 MCFSD from Council Grove, casing perfs. 2582-96', 2632-40', 2644-48', 2711-19', 2742-49', 2772-80' and 2812-20'. Shut in waiting on gas connection.