

Give All Information Completely  
Make Required Affidavit  
Mail or Deliver Report to:  
Conservation Division  
State Corporation Commission  
211 No. Broadway  
Wichita, Kansas


WELL PLUGGING RECORD

15-079-00590-0000

Harvey County. Sec. 11 Twp. 23 Rge. ~~12~~-2 (W)

Location as "NE/CNW/SW" or footage from lines NE NE NW  
Lease Owner Catt Drilling Co., Inc.  
Lease Name Stauffer Well No. 1  
Office Address Box 427, Augusta, Kansas  
Character of Well (completed as Oil, Gas or Dry Hole) Oil  
Date well completed January 12 19 63  
Application for plugging filed January 12 19 63  
Application for plugging approved January 12 19 63  
Plugging commenced January 12 19 63  
Plugging completed January 12 19 63  
Reason for abandonment of well or producing formation Dry hole

NORTH

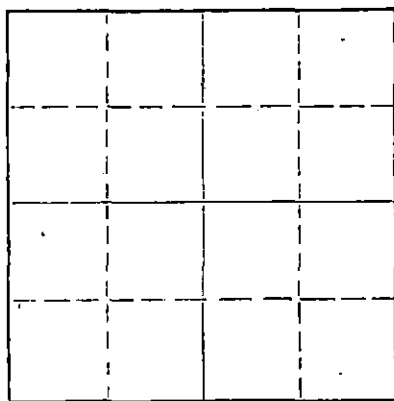

Locate well correctly on above  
Section Plot

If a producing well is abandoned, date of last production 19  
Was permission obtained from the Conservation Division or its agents before plugging was commenced? yes

Name of Conservation Agent who supervised plugging of this well Cecil M. Jones McPherson, Kans.  
Producing formation \_\_\_\_\_ Depth to top \_\_\_\_\_ Bottom \_\_\_\_\_ Total Depth of Well 3012 Feet  
Show depth and thickness of all water, oil and gas formations.

OIL, GAS OR WATER RECORDS

CASING RECORD

FORMATION	CONTENT	FROM	TO	SIZE	PUT IN	PULLED OUT

Describe in detail the manner in which the well was plugged, indicating where the mud fluid was placed and the method or methods used in introducing it into the hole. If cement or other plugs were used, state the character of same and depth placed, from \_\_\_\_\_ feet to \_\_\_\_\_ feet for each plug set.

Mud to 220' - Set plug -  $\frac{1}{2}$  sk. hulls - 20 sks. cement  
Mud to 35' - set plug - hulls - 8 sks. cement  
2 sks. cement in rat hole

JAN 21 1963

1-21-1963

CONSERVATION DIVISION  
WICHITA, KANSAS

(If additional description is necessary, use BACK of this sheet)

Name of Plugging Contractor Catt Drilling Co., Inc.  
Address Box 427, Augusta, Kansas

STATE OF Kansas COUNTY OF Butler, ss.  
George W. Catt (employee of owner) or (owner or operator) of the above-described

well, being first duly sworn on oath, says: That I have knowledge of the facts, statements, and matters herein contained and the log of the above-described well as filed and that the same are true and correct. So help me God.

(Signature) George W. Catt

(Address)

SUBSCRIBED AND SWORN to before me this 19<sup>th</sup> day of January, 19 63

Phyllis Jolly

Notary Public.

My commission expires November 23 1964



15-079-60590-000

Gatt Drilling Co., Inc.  
Stauffer #1  
NE NE NW 11-23-2W  
Harvey County, Kansas

W E L L L O G  
Started January 3, 1963  
Completed January 12, 1963  
R. T. D. 3012'

0-----	216	shale
216-----	370	shale
370-----	535	lime and shale
535-----	670	shale w/lime
670-----	770	shale and shells
870-----	1005	lime
1005-----	1170	lime w/shale
1170-----	1395	shale and lime
1395-----	1325	shale
1625-----	1843	shale w/lime
1843-----	1990	shale and shells
1990-----	2075	lime
2075-----	2135	shale and lime
2135-----	2273	shale w/lime
2273-----	2381	shale
2381-----	2446	shale and lime
2446-----	2461	shale w/lime
2461-----	2505	lime
2505-----	2525	lime
2585-----	2638	lime
2638-----	2691	lime w/shale
2691-----	2761	lime
2761-----	2825	lime
2825-----	2871	lime w/shale
2871-----	2930	shale and shells
2930-----	2990	lime and shale
2990-----	3012	limew/shale
3012-----		R. T. D.