

15-185-12011-0000


STATE OF KANSAS
STATE CORPORATION COMMISSION

WELL PLUGGING RECORD

Give All Information Completely
Make Required Affidavit
Mail or Deliver Report to:
Conservation Division
State Corporation Commission
211 No. Broadway
Wichita, Kansas

Stafford County, Sec. 25 Twp. 24S Rge. (E) 15 (W)

NORTH

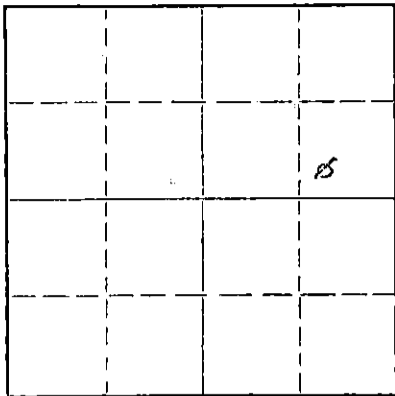

Locate well correctly on above Section Plat

Location as "NE/CNW%SW%" or footage from lines SW SE NE
Lease Owner Sunray Mid-Continent Oil Company
Lease Name Elsie Voigt Well No. 1
Office Address 321 West Douglas - Wichita, Kansas
Character of Well (completed as Oil, Gas or Dry Hole) Dry Hole
Date well completed July 9 19 60
Application for plugging filed July 12 19 60
Application for plugging approved July 13 19 60
Plugging commenced July 12 19 60
Plugging completed July 13 19 60
Reason for abandonment of well or producing formation Dry

If a producing well is abandoned, date of last production _____ 19____
Was permission obtained from the Conservation Division or its agents before plugging was commenced? Yes

Name of Conservation Agent who supervised plugging of this well Frank Broadfoot
Producing formation None Depth to top _____ Bottom _____ Total Depth of Well 3820 Feet
Show depth and thickness of all water, oil and gas formations.

OIL, GAS OR WATER RECORDS

CASING RECORD

| FORMATION | CONTENT | FROM | TO | SIZE | PUT IN | PULLED OUT |
|-------------|---------|------|------|--------|--------|------------|
| Kansas City | Dry | 3816 | T.D. | 8-5/8" | 308' | 0 |
| | | | | | | |
| | | | | | | |
| | | | | | | |
| | | | | | | |
| | | | | | | |
| | | | | | | |
| | | | | | | |

Describe in detail the manner in which the well was plugged, indicating where the mud fluid was placed and the method or methods used in introducing it into the hole. If cement or other plugs were used, state the character of same and depth placed, from _____ feet to _____ feet for each plug set.

Filled hole with mud from 3820' to 240'. Set 1/4 sack hulls and Halliburton plug @ 240' with 20 sacks cement. Cement was from 240' to 178'. Filled hole with mud from 178' to 35' and set 1/4 sack hulls and Halliburton Plug @ 35'. Ten sack cement plug from 35' to surface.

RECEIVED
STATE CORPORATION COMMISSION
JUL 23 1960
CON

7-18-60

(If additional description is necessary, use BACK of this sheet)
Name of Plugging Contractor Stickle Drilling Company
Address Tulsa, Oklahoma

STATE OF Kansas, COUNTY OF Sedgwick, ss.
Nash A. Gough (employee of owner) or owner or operator of the above-described well, being first duly sworn on oath, says: That I have knowledge of the facts, statements, and matters herein contained and the log of the above-described well as filed and that the same are true and correct. So help me God.

(Signature) Nash A. Gough
321 West Douglas - Wichita, Kansas
(Address)

SUBSCRIBED AND SWORN TO before me this 15 day of July, 19 60

My commission expires July 13, 1963
[Signature] Notary Public.

15-185-12011-0000

25-24-13W

RE

Sunray Mid-Continent Oil Company
Tulsa, Oklahoma

Tulsa, Oklahoma
July 11, 1960

Contractors: Stickle Drilling Company
Date Commenced: July 1, 1960
Date Completed: July 9, 1960

Elsie Voigt No. 1,
SW SE NE Sec. 25-24S-13W
Stafford County, Kansas

DRILLER'S LOG

Depth, Figures Indicate Base of Formations:

| | |
|-----------------------------|---------|
| Sand | 40 |
| Clay, sand and shale | 130 |
| Shale, sd. streaks & shells | 309 |
| Red Bed | 540 |
| Red bed and sand streaks | 748 |
| Anhydrite | 790 |
| Shale & shells | 1710 |
| Lime and shale | 2173 |
| Shale and lm. streaks | 2660 |
| Shale and lime | 2728 |
| Shale and lime stringers | 2985 |
| Lime and shale | 3135 |
| Lime | 3623 |
| Lime and chert | 3728 |
| Lime | 3820 TD |

RECEIVED
COMMISSION
JUL 18 1960
CONSERVATION DIVISION
Wichita, Kansas

I, Fred E. Stickle, hereby certify the above to be a true and complete Driller's Log of Sunray Mid-Continent Oil Company's Elsie Voigt Well No. 1, SW SE NE of Section 25-24S-13W., Stafford County, Kansas.

Fred E. Stickle
Fred E. Stickle

Edith A. Lawner
Notary Public

My commission expires March 24, 1968