


WELL PLUGGING RECORD

Give All Information Completely
Make Required Affidavit
Mail or Deliver Report to:
Conservation Division
State Corporation Commission
212 No. Market
Wichita, Kansas

Stafford County. Sec. 26 Twp. 24S Rge. (X) 13(W)
NE SW NE

NORTH

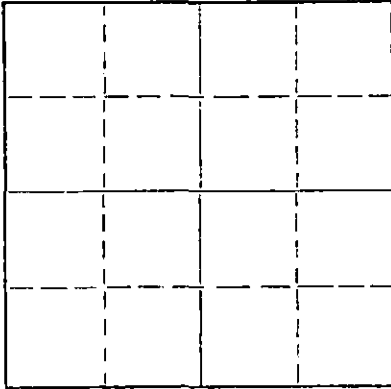

Locate well correctly on above
Section Plat

Location as "NE/CNW/SW" or footage from lines.
Lease Owner John C. Graves, et al
Lease Name Minks Well No. 1
Office Address 412 Union Center, Wichita, Kansas
Character of Well (completed as Oil, Gas or Dry Hole) Dry Hole
Date well completed September 3, 1966
Application for plugging filed September 3, 1966
Application for plugging approved September 3, 1966
Plugging commenced September 3, 1966
Plugging completed September 3, 1966
Reason for abandonment of well or producing formation

If a producing well is abandoned, date of last production 19
Was permission obtained from the Conservation Division or its agents before plugging was commenced? Yes

Name of Conservation Agent who supervised plugging of this well Archie V. Elving, Pratt, Kansas
Producing formation Depth to top Bottom Total Depth of Well 4175 Feet
Show depth and thickness of all water, oil and gas formations.

OIL, GAS OR WATER RECORDS

CASING RECORD

FORMATION	CONTENT	FROM	TO	SIZE	PUT IN	PULLED OUT
				8-5/8"	312'	None

Describe in detail the manner in which the well was plugged, indicating where the mud fluid was placed and the method or methods used in introducing it into the hole. If cement or other plugs were used, state the character of same and depth placed, from feet to feet for each plug set.

Mudded up with heavy mud to 225 feet. Followed by wooden plug and 1/2 sack hulls. Placed 25 sacks cement onto hulls. Mudded up with heavy mud to 35 feet followed by wooden plug, 1/2 sack hulls and 10 sacks cement to base of well cellar. Plugged rat hole with 2 sacks cement.

FILED
WICHITA, KANSAS

SEP 16 1966

CONSERVATION DIVISION
WICHITA, KANSAS

(If additional description is necessary, use BACK of this sheet)
Name of Plugging Contractor Graves Drilling Co., Inc.
Address 412 Union Center, Wichita, Kansas

STATE OF KANSAS, COUNTY OF BUTLER, ss.
John C. Graves (employee of owner) or (owner or operator) of the above-described

well, being first duly sworn on oath, says: That I have knowledge of the facts, statements, and matters herein contained and the log of the above-described well as filed and that the same are true and correct. So help me God.

(Signature) John C. Graves
412 Union Center, Wichita, Kansas 67202
(Address)

SUBSCRIBED AND SWORN TO before me this 6th day of September, 1966

My commission expires April 30, 1966
Betty Brandt Notary Public.

15-185-30334-0000

ROTARY DRILLERS' LOG

OPERATOR: John C. Graves, et al DRILLING COMMENCED: August 28, 1966
 412 Union Center
 Wichita, Kansas

CONTRACTOR: Graves Drilling Co., Inc. DRILLING COMPLETED: September 3, 1966
 412 Union Center
 Wichita, Kansas

CASING RECORD: 9 Jts. 312' 8-5/8" LOCATION: Minks No. 1
 cemented with 275 sacks NE SW NE
 Section 26-24S-13W
 Stafford County, Kansas

0 - 150 Soil & shale
 150 - 310 Red bed, shale & lime
 310 - 770 Red bed & shale
 770 - 788 Anhydrite
 788 - 1635 Shale & shells
 1635 - 1851 Lime & shale
 1851 - 2172 Lime
 2172 - 2440 Lime & shale
 2440 - 2900 Shale & lime
 2900 - 3305 Shale
 3305 - 3445 Sandy lime & shale
 3445 - 3643 Shale & lime
 3643 - 3848 Lime
 3848 - 3924 Shale & lime
 3924 - 4111 Lime
 4111 - 4162 Shale
 4162 - 4175 Shale & lime
 4175 Rotary Total Depth

RECEIVED
 SEP 16 1966
 DIVISION

I hereby certify the foregoing statements to be true and correct to the best of my knowledge.

GRAVES DRILLING CO., INC.

By John C. Graves
President

STATE OF KANSAS)
) SS:
BUTLER COUNTY)

Subscribed and sworn to before me, a Notary Public, this 6th of September, 1966.

Betty Brandt
Betty Brandt Notary Public

My commission expires: April 30, 1967.