

STATE OF KANSAS
STATE CORPORATION COMMISSION


WELL PLUGGING RECORD
OR
FORMATION PLUGGING RECORD

Strike out upper line
when reporting plug-
ging off formations.

Give All Information Completely
Make Required Affidavit
Mail or Deliver Report to:
Conservation Division
State Corporation Commission,
800 Bittling Building,
Wichita, Kansas

Stafford County. Sec. 27 Twp. 24 Rge. (E) 13 (W)

Location as "NE 1/4 NW 1/4 SW 1/4" or footage from lines SE NW SW
Lease Owner The Ohio Oil Company
Lease Name H. F. Sutton Well No. 1
Office Address Box 86, Wichita, Kansas.
Character of Well (Completed as Oil, Gas or Dry Hole) Dry Hole
Date, well completed January 18, 1942 19...
Application for plugging filed January 18, 19342
Application for plugging approved January 18, 19342
Plugging Commenced January 18, 19342
Plugging Completed January 18, 19342
Reason for abandonment of well or producing formation Dry

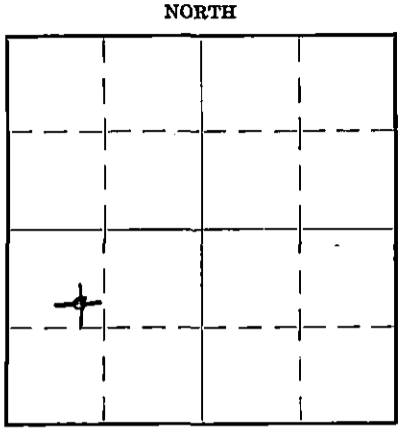

Locate well correctly on above
Section Plat

If a producing well is abandoned, date of last production 193...
Was permission obtained from the Conservation Division or its agents before plugging was com-
menced? Yes

Name of Conservation Agent who supervised plugging of this well Mr. C. T. Alexander
Producing formation None Depth to top Bottom Total Depth of Well 4200 Feet
Show depth and thickness of all water, oil and gas formations.

OIL, GAS OR WATER RECORDS

CASING RECORD

Formation	Content	From	To	Size	Put In	Pulled Out
				8-1/4"	473	None

Describe in detail the manner in which the well was plugged, indicating where the mud fluid was placed and the method or methods used in introducing it into the hole. If cement or other plugs were used, state the character of same and depth placed, from...feet to...feet for each plug set.
Hole was filled from 4200 Total Depth to 273' with 11# rotary mud. Wood bridging plug placed at 273' and 25 sacks cement pumped through drill pipe filling to 223. Filled with rotary mud to 20' below surface and topped with 10 sacks cement. Surface pipe left uncapped.

27-24-13W
22 ME-2

(If additional description is necessary use BACK of this sheet)
Correspondence regarding this well should be addressed to The Ohio Oil Company
Address P. O. Box 86, Wichita, Kansas.

STATE OF _____, COUNTY OF _____, SS.
_____(employee of owner) or (owner or operator) of the above-described well,
being first duly sworn on oath, says: That I have knowledge of the facts, statements, and matters herein contained and the log of the above-described well as filed and that the same are true and correct. So help me God.

(Signature) Burton C. Deason
Box 86, Wichita
(Address)

SUBSCRIBED AND SWORN to before me this 22nd day of January 1942

My commission expires July 28th, 1945. Ray Shaw 1-23-42
Notary Public.

LOG OF WELL

15-185-12075-0000

COMMENCED DECEMBER 14, 1941
 COMPLETED JANUARY 18, 1942

THE OHIO OIL COMPANY
 H. F. SUTTON WELL #1

SE NW SW 27 - 24 - 13W
 STAFFORD COUNTY, KANSAS.

8-1/4" casing set 473'

0 to	200	Sand & shale
	535	Sand & red rock
	740	Red rock & shells
	760	Broken anhydrite
	800	Anhydrite
	1135	Shale & shells
	1370	Salt & shale
	1500	Shale & shells
	1535	Sandy shale
	1680	Shale & shells
	1975	Shale & lime
	2030	Sand & shale
	2120	Shale & shells
	2140	Lime
	2232	Lime & shale
	2505	Broken lime
	2535	Lime
	2790	Shale
	2810	Lime
	2845	Shale
	3055	Lime & shale
	3087	Sandy lime
	3107	Lime
	3125	Sandy lime
	3480	Lime
	3573	Lime & shale
	3898	Lime
	3923	Shale & cherty lime
	3956	Shale & chat
	3957	Shale
	3978	Cherty lime
	3983	Conglomerate
	4011	Lime
	4031	Shale & cherty lime
	4043	Chert
	4057	Cheryt lime
	4079	Shale & cherty lime
	4100	Shale & lime
	4116	Sand
	4156	Sandy shale
	4200	Lime Total Depth

T. Lansing	3571
Show oil	3627 to 34
Base K. C. lime	3883
Top Viola	3957
Top Simp. sand	4097
Top Arbuckle	4156

27 24 13W
 22 2

D. & A.

1-23-42
 JAN 23 1942