

15-167-04196-00-00

STATE OF KANSAS
STATE CORPORATION COMMISSION


WELL PLUGGING RECORD

Give All Information Completely
Make Required Affidavit
Mail or Deliver Report to:
Conservation Division
State Corporation Commission
211 No. Broadway
Wichita, Kansas

Russell County. Sec. 34 Twp. 15S Rge. 15 (E)W (W)

Location as "NE/CNW/SE" or footage from lines NE NE SE
Lease Owner Helmerich & Payne, Inc.
Lease Name Michaelis Well No. 2
Office Address First National Building, Tulsa 3, Oklahoma
Character of Well (completed as Oil, Gas or Dry Hole) Dry Hole
Date well completed July 19, 1961
Application for plugging filed July 19, 1961
Application for plugging approved July 19, 1961
Plugging commenced July 19, 1961
Plugging completed July 19, 1961
Reason for abandonment of well or producing formation Dry Hole

NORTH

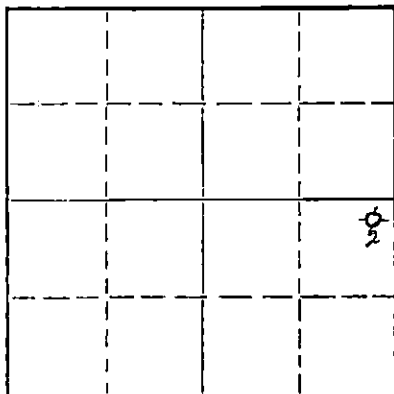

Locate well correctly on above
Section Plat

If a producing well is abandoned, date of last production _____ 19____
Was permission obtained from the Conservation Division or its agents before plugging was com-
menced? Yes

Name of Conservation Agent who supervised plugging of this well G. P. Leiker, Victoria; Harold Hollis, Gt. Bend
Producing formation _____ Depth to top _____ Bottom _____ Total Depth of Well 3880 Feet

Show depth and thickness of all water, oil and gas formations.

OIL, GAS OR WATER RECORDS

CASING RECORD

FORMATION	CONTENT	FROM	TO	SIZE	PUT IN	PULLED OUT
		0	374'	8-5/8"	374'	none

Describe in detail the manner in which the well was plugged, indicating where the mud fluid was placed and the method or methods used in introducing it into the hole. If cement or other plugs were used, state the character of same and depth placed, from _____ feet to _____ feet for each plug set.

From 3380' to 365' - heavy rotary mud
365' to 303' - 1/2 sk hulls, plug & 20 sks cement
303' to 40' - heavy rotary mud
40' to 6' - 1/2 sk hulls, plug & 10 sks cement
6' to surface - cellar

7-28-61

(If additional description is necessary, use BACK of this sheet)

Name of Plugging Contractor Peel Brothers, Inc.
Address P.O. Box 359, Hoisington, Kansas

STATE OF KANSAS, COUNTY OF BARTON, ss.
Peel Brothers, Inc. (employee of owner) or (owner) of the above-described well, being first duly sworn on oath, says: That I have knowledge of the facts, statements, and matters herein contained and the log of the above-described well as filed and that the same are true and correct. So help me God. PEEL BROTHERS, INC.

(Signature) BY: Wendell E. Peel
P.O. Box 359, Hoisington, Kansas
(Address)

SUBSCRIBED AND SWORN TO before me this 21st day of July, 1961

My commission expires April 27, 1964

Ruth Brant
Notary Public.



DRILLERS' LOG

Well Owner: Helmerich & Payne, Inc.
 Farm Name: Michaelis Well #2
 Commenced: 7/11/61
 Completed: 7/19/61
 Total Depth: 3380'
 Casing: 8-5/8" @ 374' cem.
 Contractor: Peel Brothers, Inc.

NE NE SE
 Sec. 34, Twp. 15S, Rge 15W,
 County, Russell,
 Kansas

Elevation: 1950

Production: Dry

Figures below indicate bottoms of formations:

Clay & post rock	0	-	40
Sand and shale			120
Red bed and shale			376
Sand and shale			520
Sand			630
Sand and red bed			980
Anhydrite			1012
Shale			1080
Shale and shells			1480
Shale			1650
Shale and lime			1760
Some			2130
Lime and shale			2440
Shale			2630
Shale and lime			2790
Lime			3380
T.D.			3380

This is to certify that the above information is to the best of our knowledge, true and correct.

PEEL BROTHERS, INC.

BY: Kendall P. Peeg

SUBSCRIBED AND SWORN to before me this 21st day of July, 1961

My commission expires: April 27, 1964

Rich Brant
 Notary Public

REIVED
 NOTARY PUBLIC

21

1961