


15-095-00375-0000

WELL PLUGGING RECORD

Give All Information Completely
Make Required Affidavit
Mail or Deliver Report to:
Conservation Division
State Corporation Commission
800 Biting Building
Wichita, Kansas

Kingman County, Sec. 26 Twp. 27 Rge. (E) 5 (W)
Location as "NE/CNWxSWx" or footage from lines NW NW NE
Lease Owner F. Kirk Johnson Oil Company, Fort Worth, Texas.
Lease Name BONJOUR Well No. 1
Office Address Fort Worth, Texas. (3101 Winthrop)
Character of Well (completed as Oil, Gas or Dry Hole) Dry hole
Date well completed December 24, 19 54
Application for plugging filed verbally - December 24, 19 54
Application for plugging approved verbally - December 24, 19 54
Plugging commenced December 24, 19 54
Plugging completed December 24, 19 54
Reason for abandonment of well or producing formation Dry hole

NORTH

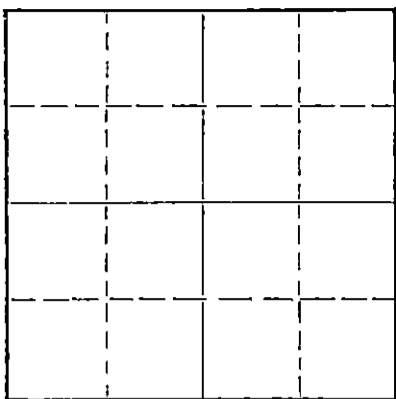

Locate well correctly on above
Section Plat

If a producing well is abandoned, date of last production 19
Was permission obtained from the Conservation Division or its agents before plugging was commenced? verbally - yes

Name of Conservation Agent who supervised plugging of this well
Producing formation Depth to top Bottom Total Depth of Well 3873' Feet
Show depth and thickness of all water, oil and gas formations.

OIL, GAS OR WATER RECORDS

CASING RECORD

FORMATION	CONTENT	FROM	TO	SIZE	PUT IN	PULLED OUT
				8-5/8"	200'	

Describe in detail the manner in which the well was plugged, indicating where the mud fluid was placed and the method or methods used in introducing it into the hole. If cement or other plugs were used, state the character of same and depth placed, from feet to feet for each plug set.

Filled hole with heavy mud to 188'
1st plug set solid bridge at 188 with 155 sacks cement.
Filled hole with heavy mud to 40'.
2nd plug set solid bridge at 40' with 10 sacks cement.

(If additional description is necessary, use BACK of this sheet)

Name of Plugging Contractor Musgrove Petroleum Corporation
Address 518 Petroleum Building, Wichita, Kansas.

STATE OF Kansas COUNTY OF Sedgwick
Gordon L. Koelling (employee of owner) or (owner/operator) of the above-described well, being first duly sworn on oath, says: That I have knowledge of the facts, statements, and matters herein contained and the log of the above-described well as filed and that the same are true and correct. So help me God.

(Signature) _____
518 Petroleum Building, Wichita, Kansas.
(Address)

SUBSCRIBED AND SWORN to before me this 30th day of December, 19 54

My commission expires July 16, 1955.

Notary Public.

PLUGGING
FILE SEC 26 T 27 R 54
BOX PAGE 17 LINE 12

CONFEEV - 4-55

CONTRACTOR'S WELL LOG

COMPANY: F. Kirk Johnson Oil Co.,
Fort Worth, Texas.
CONTRACTOR: Musgrove Petroleum Corporation
FARM: BONJOUR #1
LOCATION: NW NW NE 26-27-5
Kingman County, Kansas.
COMMENCED: December 13, 1954
COMPLETED: December 24, 1954

0	50	Sand
50	205	Sand & red bed
205	770	Shale
770	911	Anhydrite & shale streaks
911	1110	Shale
1110	1417	Shale & shells
1417	1510	Shale & lime
1510	1775	Shale
1775	2085	Shale & shells
2085	2260	Shale & lime
2260	2657	Shale & shells
2657	2760	Shale & lime
2760	2954	Shale & lime
2954	3790	Lime & shale
3790	3873	Lime- Mississippi
	3873	Rotary Total Depth

Set 8-5/8" surface at 200' with 135 sacks cement.

Dry and Abandoned.

STATE OF KANSAS)
) SS
COUNTY OF SEDGWICK)

I, GORDON L. KOELLING, do hereby certify that the above and foregoing is a true and correct copy of the log of the BONJOUR #1, NW NW NE, Section 26-27-5, Kingman County, Kansas, as reflected by the files of the Musgrove Petroleum Corporation.

MUSGROVE PETROLEUM CORPORATION

BY [Signature]
Secretary-Treasurer

Subscribed and sworn to before me, a Notary Public, in and for Sedgwick County, Kansas, this 30th day of December, 1954.

[Signature]
Notary Public

My commission expires July 16, 1955.

PLUGGING
FILE SEC 26-27-5 SW
BOOK PAGE 87 LINE 12

CONSERVATION DIVISION
WARRANTS