

STATE OF KANSAS
STATE CORPORATION COMMISSION


Form CP-4
15-095-00375-8001

WELL PLUGGING RECORD

Give All Information Completely
Make Required Affidavit
Mail or Deliver Report to:
Conservation Division
State Corporation Commission
211 No. Broadway
Wichita, Kansas

Kingman County, Sec. 26 Twp. 27S Rge. (E) 5 (W)

Location as "NE/CNW/SW" or footage from lines NW/4 NW/4 NE/4
Lease Owner Skelly Oil Company
Lease Name P. M. Bonjour Well No. 1
Office Address P.O. Box 1650, Tulsa, Oklahoma
Character of Well (completed as Oil, Gas or Dry Hole) Dry Hole
Date well completed August 4, 1965
Application for plugging filed August 5, 1965
Application for plugging approved August 6, 1965
Plugging commenced August 5, 1965
Plugging completed August 5, 1965
Reason for abandonment of well or producing formation Dry Hole

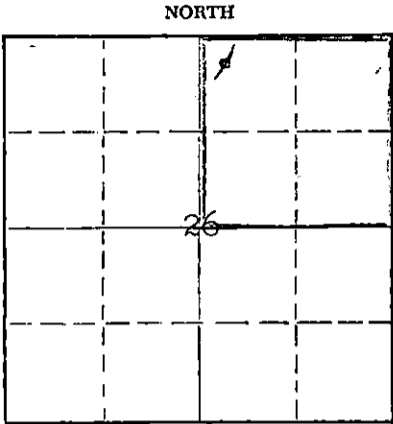

Locate well correctly on above Section Plat

If a producing well is abandoned, date of last production 19____
Was permission obtained from the Conservation Division or its agents before plugging was commenced? Yes (verbally)

Name of Conservation Agent who supervised plugging of this well Mr. A. Elving
Producing formation _____ Depth to top _____ Bottom _____ Total Depth of Well 4221 Feet
Show depth and thickness of all water, oil and gas formations.

OIL, GAS OR WATER RECORDS

CASING RECORD

FORMATION	CONTENT	FROM	TO	SIZE	PUT IN	PULLED OUT
				8-5/8"	* ?	None
	*Surface casing run by	previous	owner			

Describe in detail the manner in which the well was plugged, indicating where the mud fluid was placed and the method or methods used in introducing it into the hole. If cement or other plugs were used, state the character of same and depth placed, from _____ feet to _____ feet for each plug set.

Mud	4221' to 180'
Rock bridge	180' to 140'
Mud and hull bridge	140' to 130'
25 sacks of cement	130' to 35'
Mud and hull bridge	35' to 25'
10 sacks of cement	25' to Base cellar
Surface soil	Cellar to Surface

RECEIVED
STATE CORPORATION COMMISSION

OCT 15 1965
10-15-65

CONSERVATION DIVISION
Wichita, Kansas

(If additional description is necessary, use BACK of this sheet)

Name of Plugging Contractor Leben Drilling, Inc.
Address Box 486, Great Bend, Kansas

STATE OF Nebraska, COUNTY OF Red Willow, ss.
C. F. Bass (employee of owner) or (owner or operator) of the above-described well, being first duly sworn on oath, says: That I have knowledge of the facts, statements, and matters herein contained and the log of the above-described well as filed and that the same are true and correct. So help me God.

(Signature) *C. F. Bass*

P. O. Box 649, McCook, Nebr. 69001
(Address)

SUBSCRIBED AND SWORN TO before me this 18th day of October, 1965

C. E. Lindsey
Notary Public.

My commission expires June 13, 1969

DRILLER'S LOG

15-095-00375-0001

COMPANY: Skelly Oil Company
 CONTRACTOR: LEBEN DRILLING, INC.
 FARM: P. M. BONJOUR #1
 LOCATION: NW NW NE Sec. 26-27S-5W
 KINGMAN COUNTY, KANSAS
 COMMENCED: 7-31-65
 COMPLETED: 8-5-65

RECEIVED
STATE CORPORATION COMMISSION

AUG 9 - 1965

CONSERVATION DIVISION
Wichita, Kansas

0	3873	Washed Down
3873	4044	Lime
4044	4110	Lime & Shale
4110	4167	Shale
4167	4200	Shale & Lime
4200	4223	Sand
	<u>4223</u>	<u>RTD - D. & A.</u>

Surface casing set by Previous Operator

I, Leslie Kite, do hereby certify that the above and foregoing is a true and correct copy of the log of the P. M. Bonjour #1 washdown well, located NW NW NE of Section 26, Township 27 South, Range 5 West, Kingman County, Kansas, as reflected by the records of Leben Drilling, Inc.


Leslie Kite
Leslie Kite

STATE OF KANSAS)
) SS
COUNTY OF BARTON)

Subscribed and sworn to before me, a Notary Public, in and for Barton County, Kansas, this 6th day of August, 1965.

Ulanda Nichols
Ulanda Nichols

My Commission Expires:
April 1, 1967

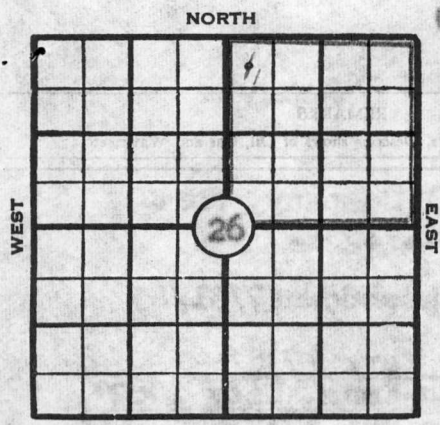

ORIGINALLY DRILLED BY F. KIRK JOHNSON OIL COMPANY,
Fort Worth, Texas

SKELLY OIL COMPANY

Well Record 15-095-00375000

Lease Name and No. P. M. Bonjour #79708 Well No. 1
Lease Description NE/4 Section 26-27S-5W
Kingman County, Kansas (160 Acres)

Location Staked _____ 19____ by _____
330 feet from north line 1980 feet from east line
of Section 26

Elev. K.B. 1496'
D.F.
Elev. G.L. 1491'

Drilling Contractor Leben Drilling, Inc.

Work Com'd. July 31, 1965 Drilling Com'd. _____ 19____ Reached Total Depth August 4, 1965

Rotary Drilling from 3873' to 4221' Cable Tool Drilling from _____ to _____

Washed down with rotary tools from Surf. to 3873'
Well Completed _____ 19____ Total Depth 4221' P.B.T.D. _____

Initial Completion Test _____ 19____

Pressures: F.C.P. _____ F.T.P. _____ S.I.C.P. _____ S.I.T.P. _____

PRODUCING FROM

FORMATION	thru OPEN HOLE PERFORATIONS	TOP	BOTTOM	Total No. Shots
<u>PLUGGED AND ABANDONED</u>				
FORMATION	thru OPEN HOLE PERFORATIONS	TOP	BOTTOM	Total No. Shots
FORMATION	thru OPEN HOLE PERFORATIONS	TOP	BOTTOM	Total No. Shots
FORMATION	thru OPEN HOLE PERFORATIONS	TOP	BOTTOM	Total No. Shots

CASING RECORD

STRINGS	SIZE	WHERE SET (Depth)	CEMENTING RECORD		All Measurements were taken from top of Kelly Bushing which is _____ ft. Derrick Floor
			Sacks Used	Top Cem't Bh'd. Cas'g.	
Surface	<u>8-5/8"</u>	<u>205'</u>	<u>?</u>	<u>Surface</u>	from top of surface casing <u>Flange Collar</u>
Intermediate					
Production					
Liner					Top Liner:

Size	Wt.	Thds.	Kind	Cond.	LEFT IN				PULLED OUT					
					Jts.	LTM		WTM		Jts.	LTM		WTM	
						Feet	In.	Feet	In.		Feet	In.	Feet	In.
<u>8-5/8"</u>						<u>(Description unknown, csg. put in by previous operator)</u>								

SIGNIFICANT GEOLOGICAL FORMATIONS

NAME	TOP	BOTTOM	GAS		OIL		REMARKS
			FROM	TO	FROM	TO	
<u>*Schlumberger Tops</u>							
<u>Indian Cave</u>	<u>1736'</u>						
<u>Lans.-Kans. City</u>	<u>2962'</u>						
<u>*Mississippi</u>	<u>3738'</u>						
<u>*Kinderhook</u>	<u>4050'</u>						
<u>*Harnaton</u>	<u>4138'</u>						
<u>*Viola</u>	<u>4176'</u>						
<u>*Simpson</u>	<u>4192'</u>						

TREATMENT RECORD

DATE	TYPE TREATMENT	INTERVAL TREATED	AMOUNT OF TREATMENT

WORKOVER RECORD

TYPE WORK	DATE COM'D.	DATE COMP.	Plugged back or Deepened		PROD. BEFORE	PROD. AFTER
			FROM	TO		

15-095-00375-0001

RECORD OF FORMATIONS

FORMATION	TOP	BOTTOM	REMARKS
-----------	-----	--------	---------

This well was originally drilled by F. Kirk Johnson Oil Company, Fort Worth, Texas, and was plugged and abandoned December 24, 1954.

Cement Washed down to original total depth	Surf.	10	Commenced washdown 7/31/65
	10	3873	Top Indian Cave 1736° Top Lansing-Kans. City 2962° Top Mississippi 3738° (Conditioned Hole) DRILL STEM TEST NO. 1 3749°-3873°, tool open 45 mins., strong blow, gas to surface in 2 mins., gas gauged 620 MCF and declined to 499 MCF at end of 45 mins.; recovered 135° gas cut mud, 60° water cut mud, 100° muddy water, IFP-167//45 minutes, FFP-223//45 mins., IBHP-1432//45 mins., FEHP 1404//45.

Drilled deeper:			
Line	3873	3975	
Line and chert	3975	4013	Top Kinderhook 4050°
Line	4013	4044	
Lime and shale	4044	4200	Top Marmaton 4138° Top Viola 4176° Top Simpson 4192°
Sand	4200	4223	Total Depth Reached 8/4/65
Total depth (Driller)		4223°	
TOTAL DEPTH (Schlumberger)		4221°	

Ran Schlumberger Dual Induction-Laterolog and Sonic Log-Gamma Ray Log to 4221°.

As the well was found to be non-productive of either oil or gas in testing and drilling through the Simpson Sand, regular authority was granted to plug and abandon the well.

On August 5, 1965, commenced plugging the well as follows:

Mud	4221° to 180°
Rock bridge	180° to 140°
Mud and hull bridge	140° to 130°
25 sacks of cement	130° to 35°
Mud and hull bridge	35° to 25°
10 sacks of cement	25° to base cellar
Surface soil	Cellar to surface

Plugged and abandoned August 5, 1965.

RECEIVED
 STATE CORPORATION COMMISSION
 OCT 15 1965
 CONSERVATION DIVISION
 Wichita, Kansas